


72 BRIDGE ROAD

11-24-2021

#72

Garage

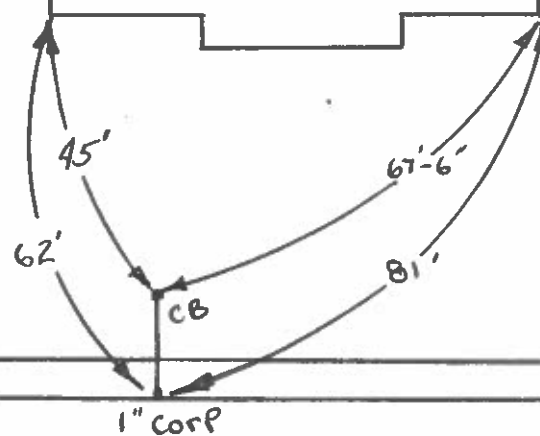

1" CtSP
M-C

8" DI.

1" Corp