


106 RIDGE ROAD

11-29-2021

#106

Garage

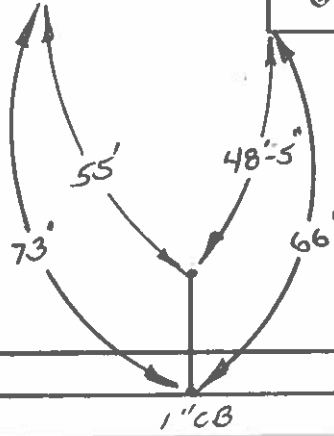

1" ctsP
m-c
19'-5"

8" DI

1"CB