


112 RIDGE ROAD

11-29-2021

Garage

#112

1" CTSP
M-C
19'

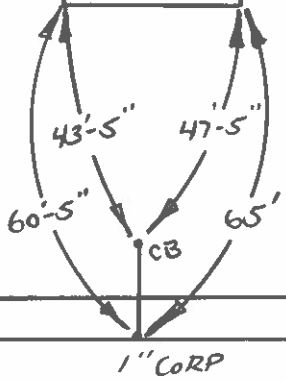

8" DI

1" CoRP