

NO. STREET

4

DATE INST.

MAKE:

SIZE


SAUGUS AVENUE

7/27/04

BADGER

1"

westwood

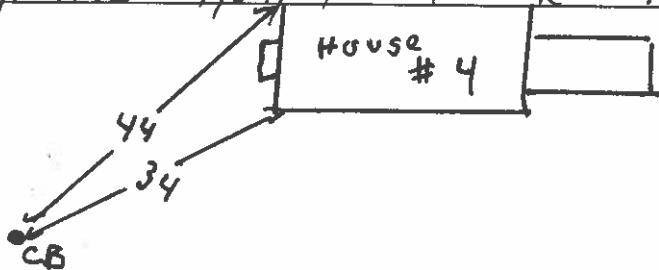

Saugus