


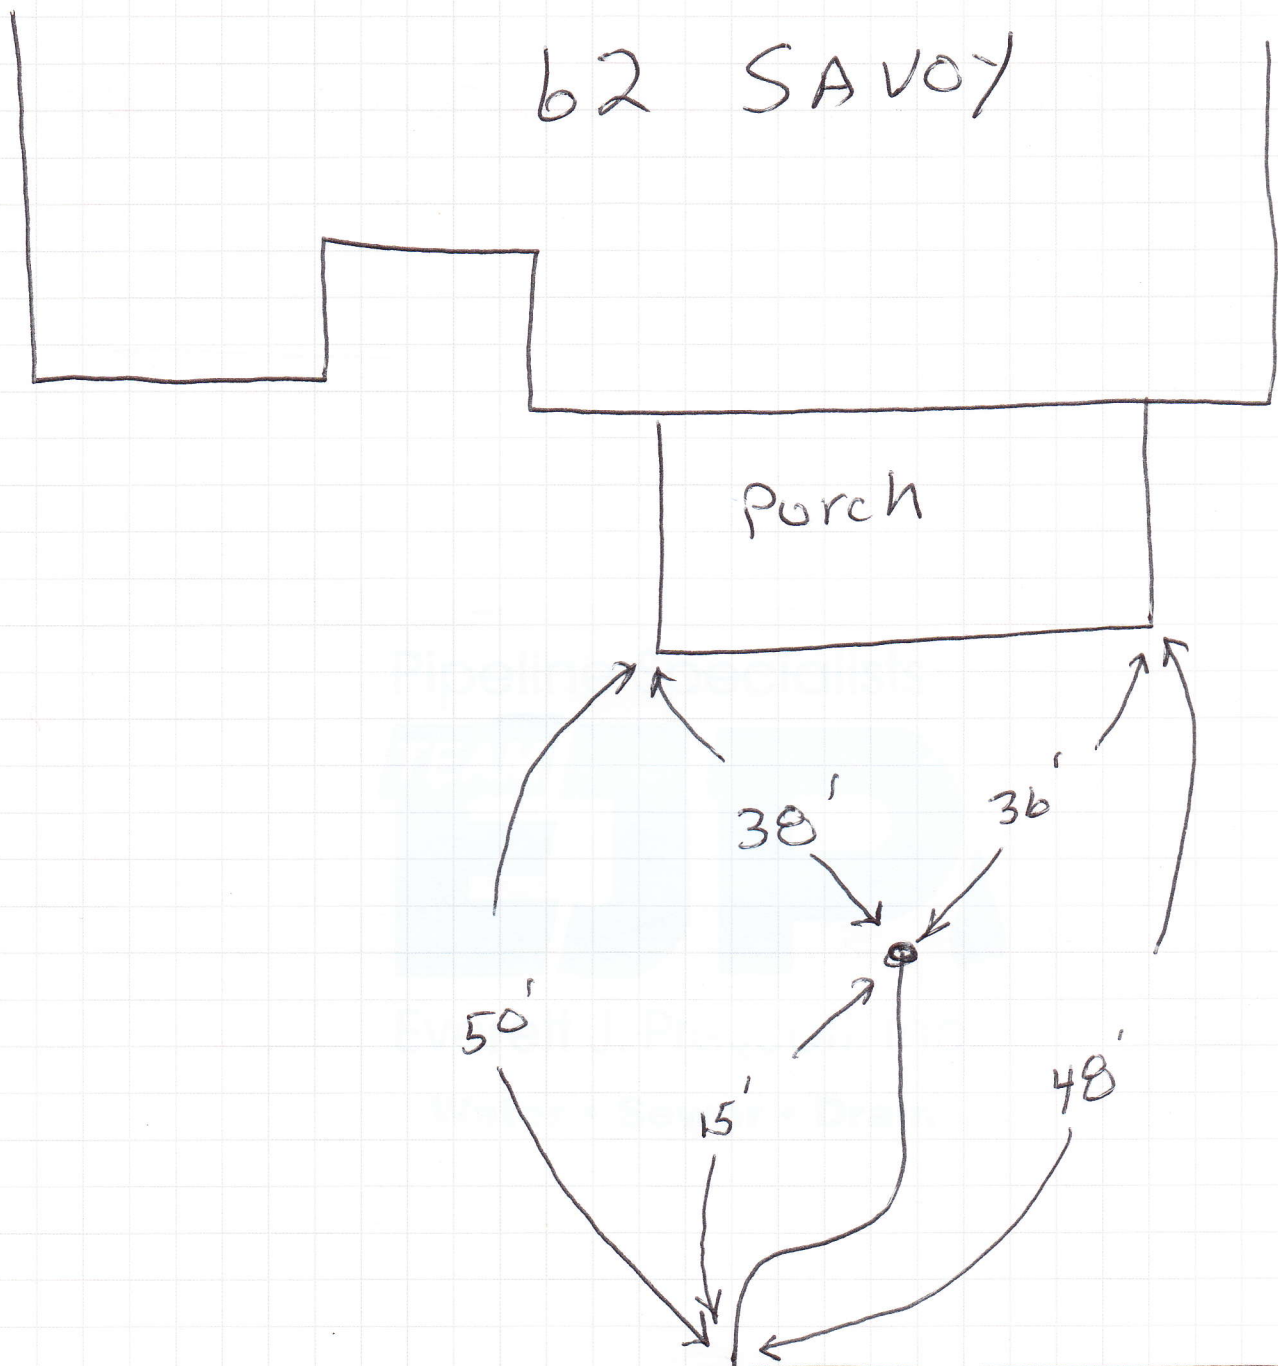

8" DI

note: WATER & 4" sewer
in same ditch