


35
School
st.

Hydrant
256

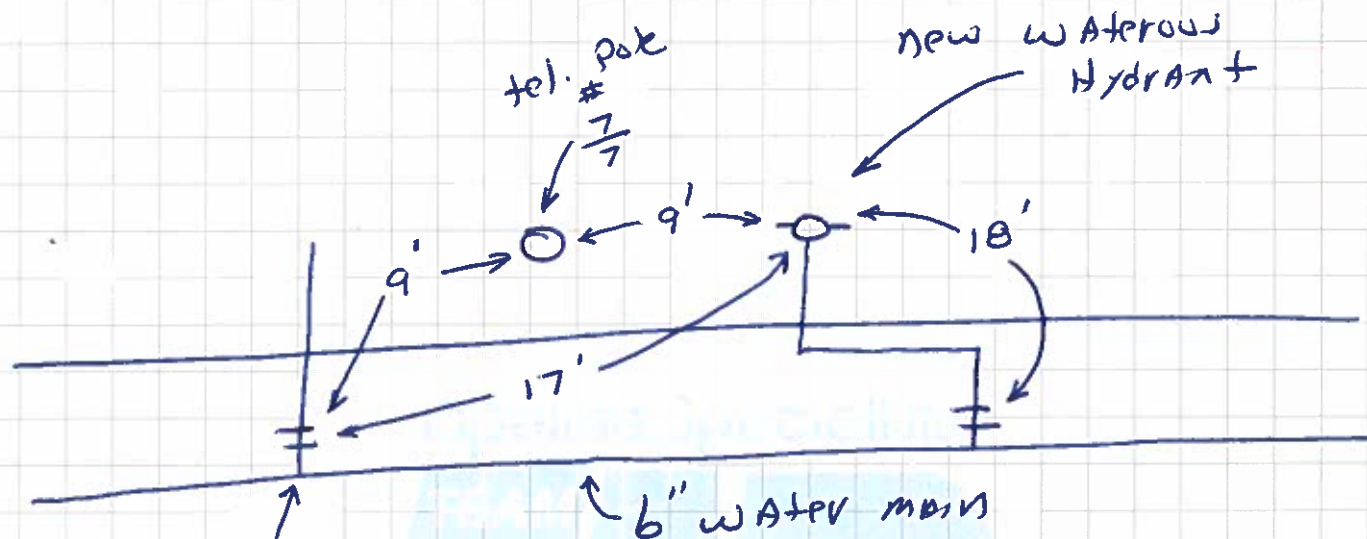

WG to OLD
center School
is off

School
street