



EAST LONGMEADOW DEPARTMENT OF PUBLIC WORKS


Job: SHAKER ROAD

Sheet No: _____ of _____

Calculated By: _____ Date: _____

Scale: _____

HYDRANT NOT shown on GIS - Please Add

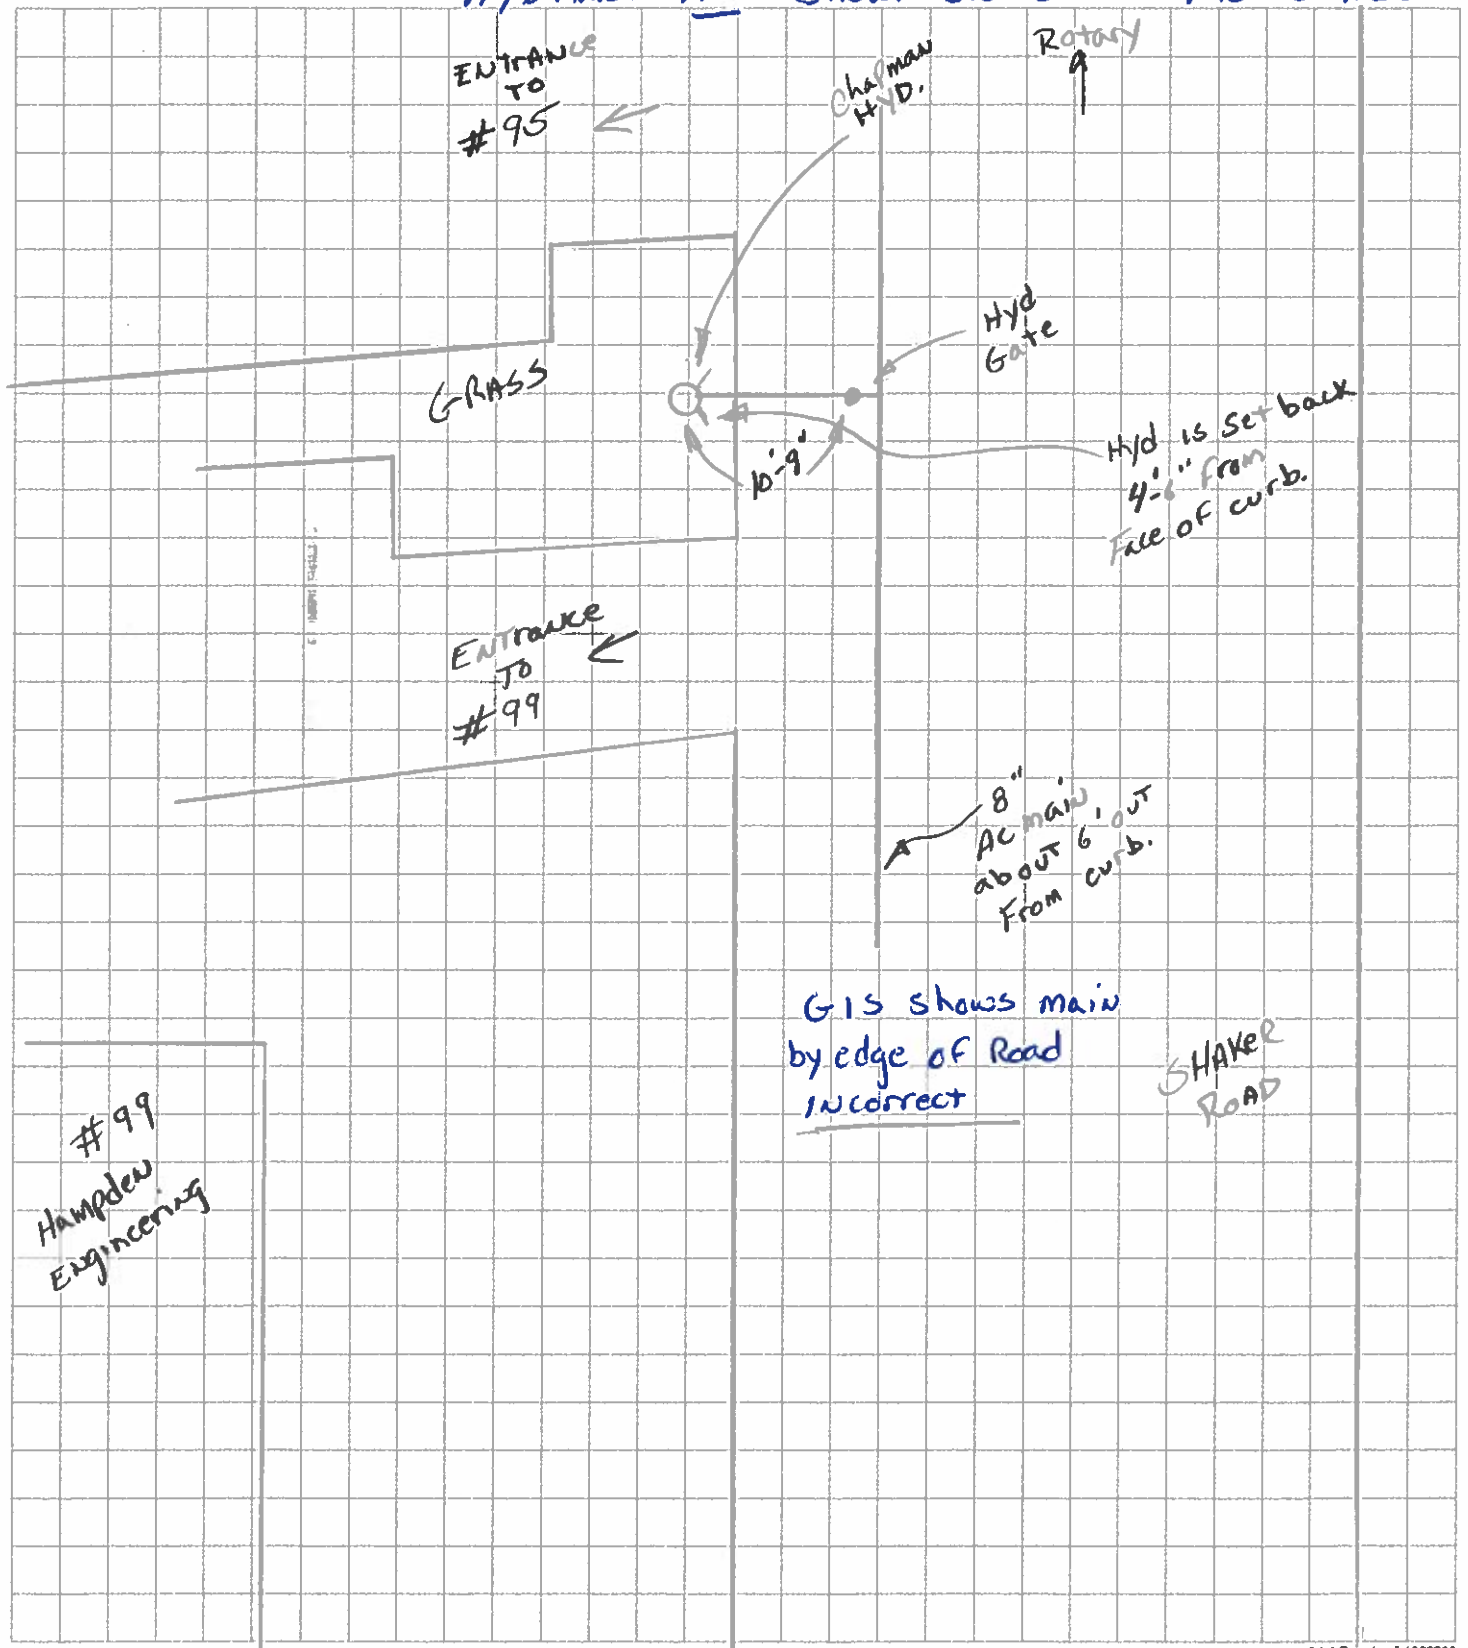



EAST LONGMEADOW DEPARTMENT OF PUBLIC WORKS

Job: 78 SHAKER

Sheet No: _____ of _____

Calculated By: _____ Date: _____

Scale: _____

GIS currently shows MAIN near center of Shaker Rd.
This is incorrect.

