


EAST LONGMEADOW DEPARTMENT OF PUBLIC WORKS

Job: 227 Shaker Rd. (water)

Sheet No: (Gas Station) of _____

Calculated By: Josh C. Date 2-8-2017

Scale: _____

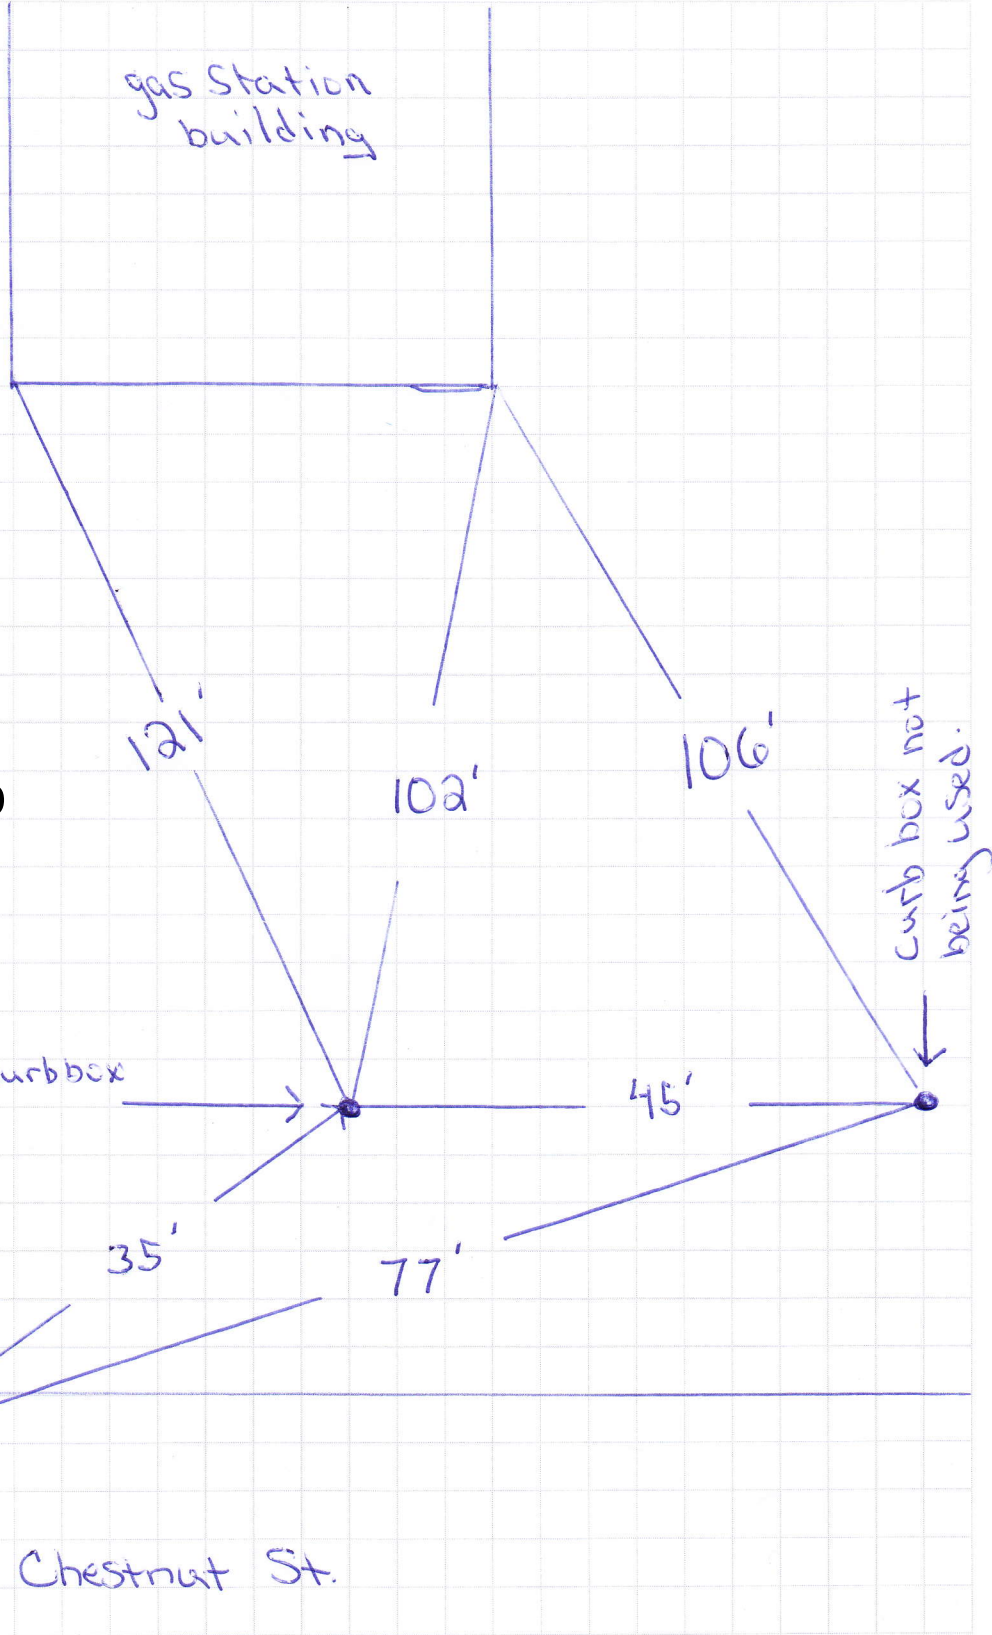

3/4" Curb Stop
70 PSI
40 GPM

Catch basin
ID # 3017

Chestnut St.