

No. 104 Slumber Lane

~~Street~~

Pt. Lot 33

Owner Gralia Bros.

S. R. 57706

Date

2-12-58

Work Done

Service pipe laid by

M. J. Shaughnessy (C. Turcotte)

Buffalo box in st. over 1" IK made onto 3/4" Corp.
8'10" S of N line of house, 34'11" N of S line of house,
59'2" out from house, 34'1" S of S line of house #114.


2-12-58

CLAUDE TURCOTTE
(M.J.S.)

{ 27'0"
33'6"

#104

3/4" Copper Tubing furnished by de l'Es
3/4" " " " owner
#114

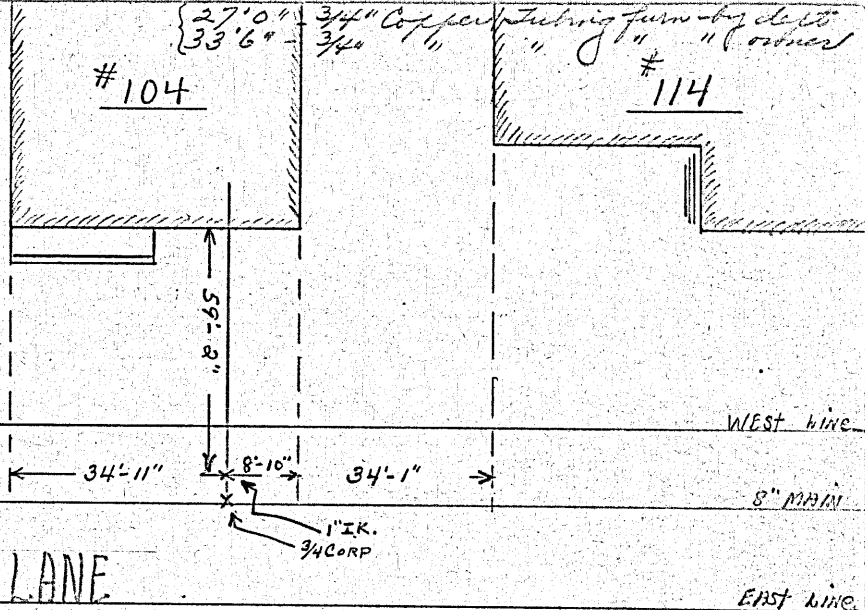

WEST LINE

8" MAIN

EAST LINE