

No. 114 Slumber Lane

Street

Lot 32

Owner Grajia Bros.

S. R. 56334

Date

Work Done

11-16-56

Service pipe laid by W.E.Mowrey


8-20-65

Used 16" SB ext. over SR a/c repaving-Brown

Buffalo box over 1" IK made onto 3/4" Corp. 62'0" out
from body of house, 20'10" S of N line of house, 18'8"
N of S line of house, 13'0" NW from hydt.

10'8" - 3/4" Copper Tubing (runs by deck)
54'0" - 3/4" " " " (" " corner)

11-16-56

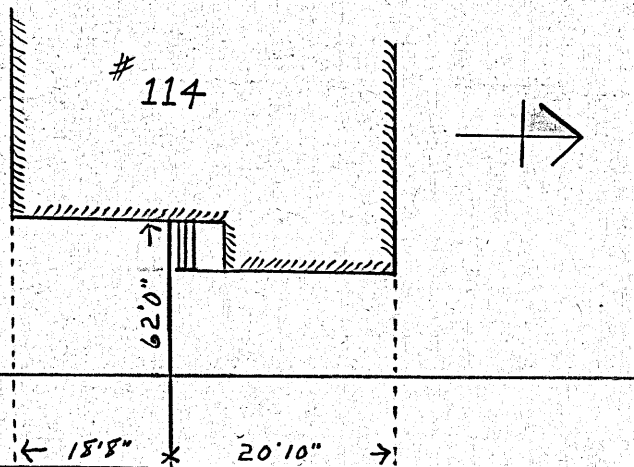

CELIA ST.

SLUMBERLANE HYDT.