

No. 143 Slumber Lane

Street

Lot 13

Owner Gralia Bros. Inc.

S. R. 59184

Date

Work Done

3-30-59

Service pipe laid by W.E.Mowrey


8-20-65

Used 16" SB ext over SR a/c repaving-Brown

Buffalo box in st. over 1" IK near 3/4" Corp. Tapped on top 49'9" out from house, 13'0" S of N line of house, 22'0" N of S line of body of house, 31'9" N of N line of house #140.

52'0" - 3/4" Copper Outing

MARCH 30, 1959
W. MOWREY

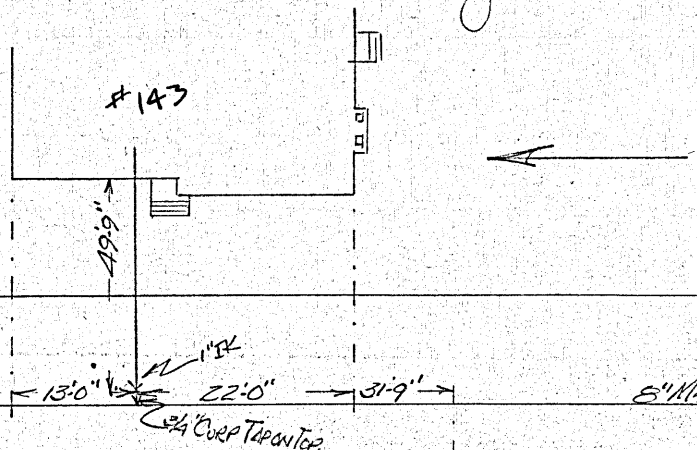

#143



SLUMBER LANE

#140