

No. 160 Slumber Lane

Street Lot#36

Owner Frank C. Gotta

S. R. 700073A

Date

Work Done

5-23-70


Service pipe laid by /Cunningham, to st. line.

8-31-70

Extended into house-J.Kennedy

Buffalo box in st. over 1" IK made onto 3/4" corp.,
57'2" out from house, 19'0" W of E line of house, 24'0"
E of W line of house, 4'0" E of E line of house #169.

34'0" 3/4" C.T. By DEPT- 5-23-70
25'8" " " " " 8-31-70

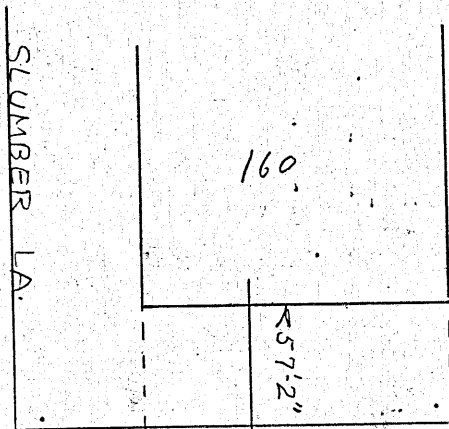

19'0" 4'0" 24'0"
1" IK
3" CORP.

8" A1A1N

SLUMBER

LANE.

#169.