

No. 185 Slumber Lane

~~181AM~~ Lot #41

Owner Frank C. Gotta

S. R. 700068-A

Date

Work Done

5-22-70

Service pipe laid by Cunningham, to treebelt.

10-17-70

Extended into house-Roncarati *Left off- no valve or meter.*

  CONNECTION ON CAROL ANN STREET

Buffalo Box in st. over 1" IK made onto 3/4" Corp.

8'2" W of E line of house, 16'0" E of W line of house,


46'0" out from house, 26'6" E of E line of #183.

15'0" - 3/4" C.T. turn by Sept. to pt. line - 5-22-7.
 39'0" - 3/4" C.T. " " " from above into house - 10-17-70

183

185

SLUMBER LANE.

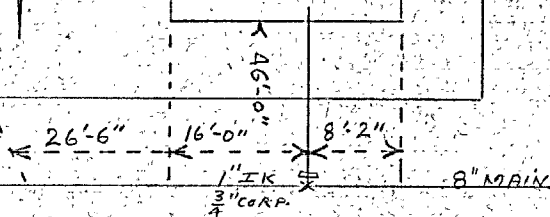

CAROLANN STREET.