


EAST LONGMEADOW DEPARTMENT OF PUBLIC WORKS

lob: 26 Smith Ave	(water)
Sheet No:	of
Calculated By: Pope	Date <u>5-19-22</u>
Paola.	

MCR JHH3 V

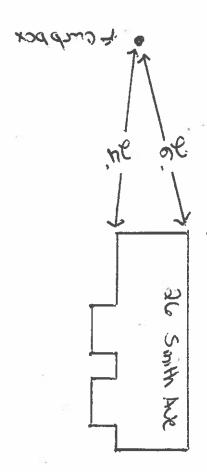

west wood Ave