




EAST LONGMEADOW DEPARTMENT OF PUBLIC WORKS

Job: 129 Somers Rd (water)

Sheet No: _____ of _____

Calculated By: Pope Date 8-14-19

Scale: _____

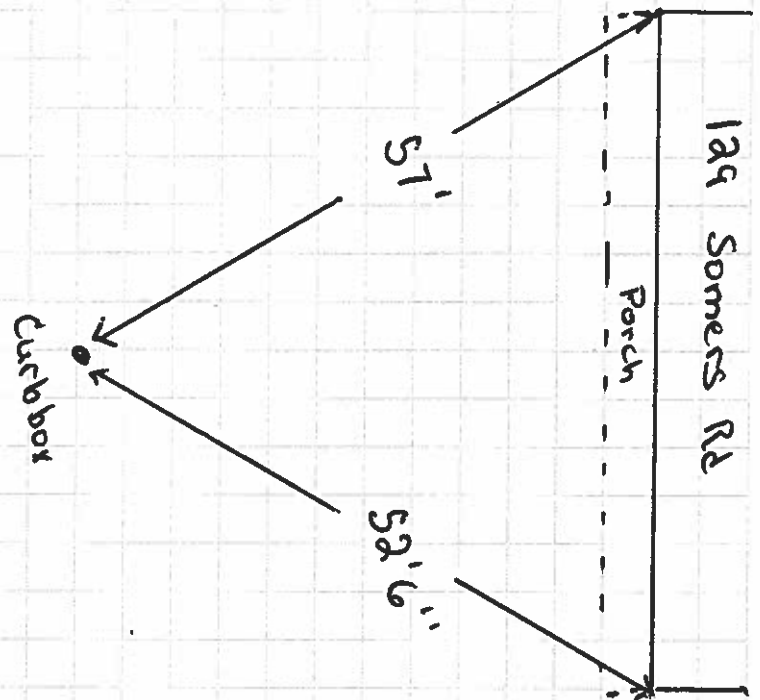

Side walk

Somers Rd