

NO. STREET

DATE INST.


MAKE:

SIZE

229 SOMERS ROAD

10/03 RECORD DWG.

SOMERS RD.

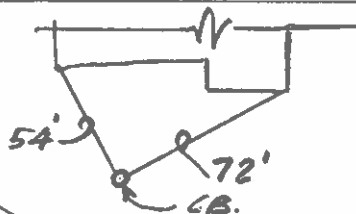

CHESTNUT ST.