




EAST LONGMEADOW DEPARTMENT OF PUBLIC WORKS

Job: 614 Somers Rd. (water)

Sheet No: _____ of _____

Calculated By: Pope Date 1-31-17

Scale: _____

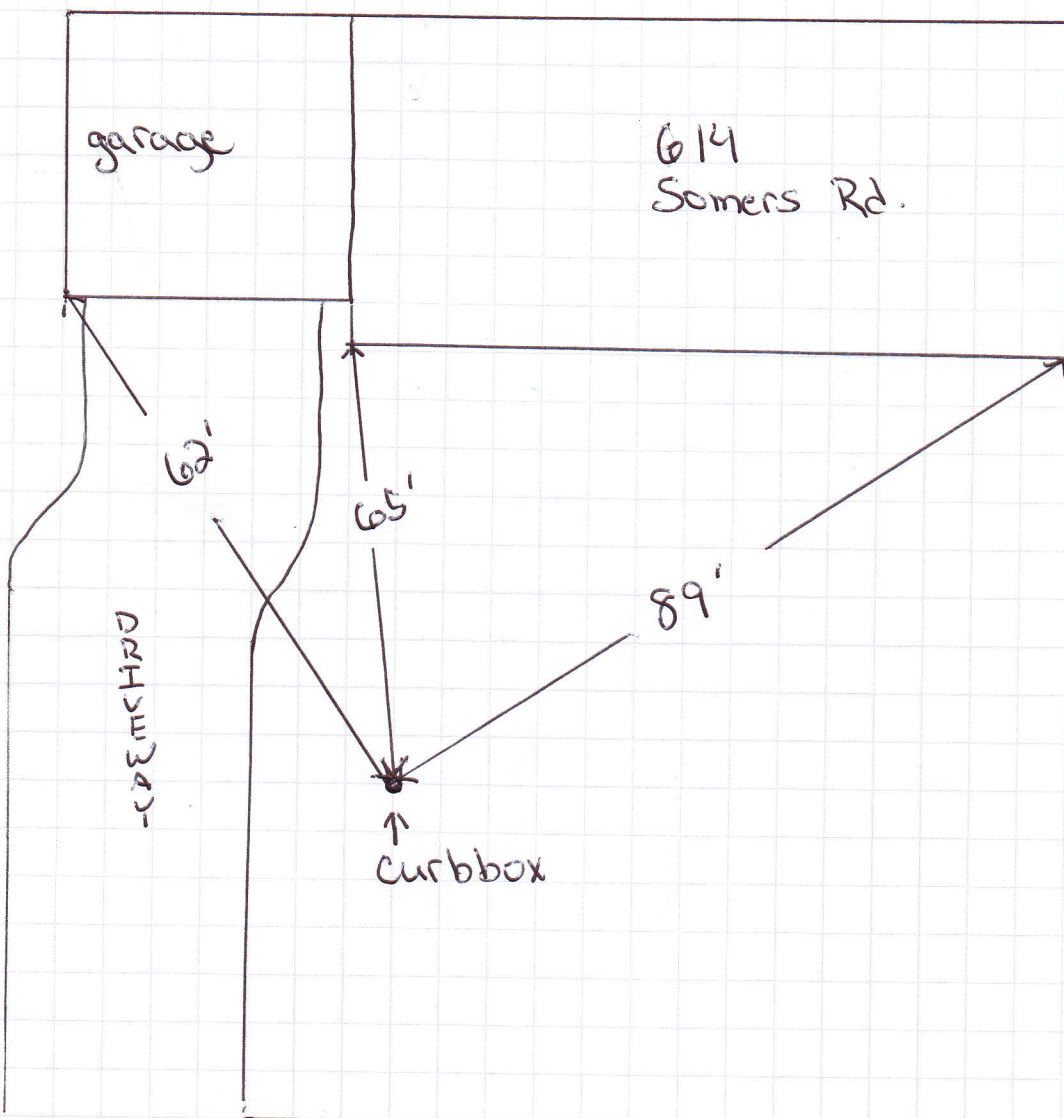

Somers Rd