




EAST LONGMEADOW DEPARTMENT OF PUBLIC WORKS

Job: # 7 St Joseph Dr Water Service Repair
Sheet No: 1 of 1
Calculated By: Foia Date 09/03/20
Scale: Feet

Service was leaking at Corp threads was -
Direct TAP to AC

9-3-20
Installed 3/4" saddle
new 3/4" corp.

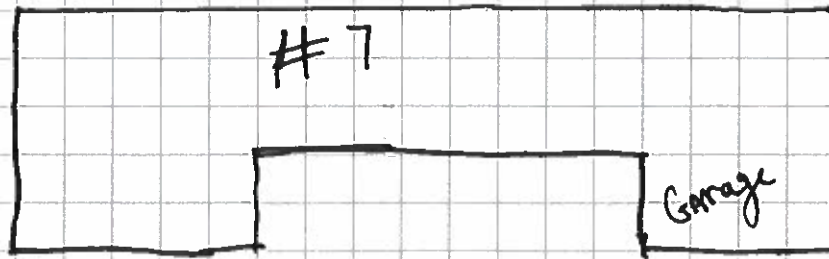

3/4"
McDonald Corp.

6" AC Water Main

6" AC Water Main

Bury Depth
5'02"