

NO. STREET


DATE INST.

MAKE:

SIZE

43 Sutton Place 2-29-00 Budget 1"

Sutton Place

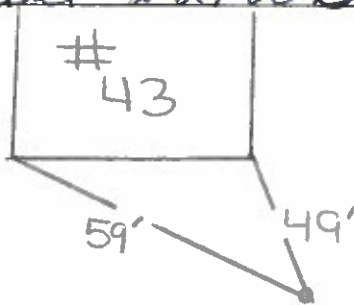

Fox Hedge Road