


JOB NO.: E526

STREET ADDRESS: HSE#5 TAYLOR AVENUE

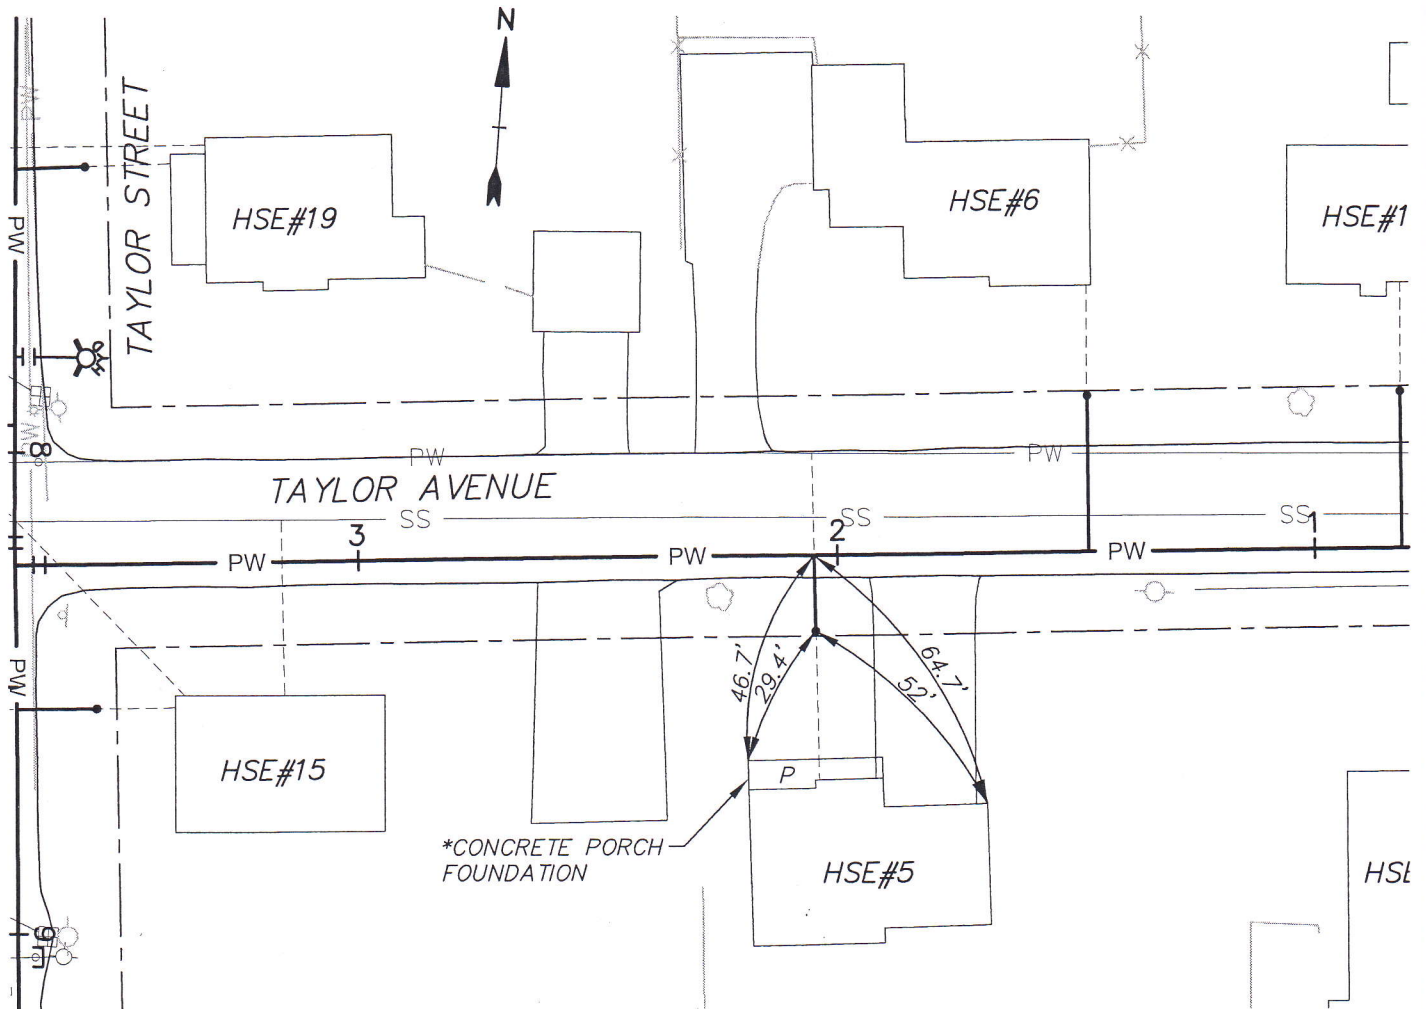

LOAM & SEED \_\_\_\_\_  
BIT. DRIVEWAY \_\_\_\_\_  
BIT. CURBS \_\_\_\_\_  
BIT. SIDEWALK \_\_\_\_\_  
CONC. CURB \_\_\_\_\_  
CONC. SIDEWALK \_\_\_\_\_

SERVICE INSTALLED: 9-17-07  
SIZE: 1"  
MATERIAL: \_\_\_\_\_  
DEPTH AT MAIN: 5.5'  
DEPTH AT CURB STOP: 5.4'  
LENGTH OF Cu PIPE: 18.5'