




EAST LONGMEADOW DEPARTMENT OF PUBLIC WORKS

Job: 7 Taylor St (water)

Sheet No: _____ of _____

Calculated By: pope Date 8-14-17

Scale: _____

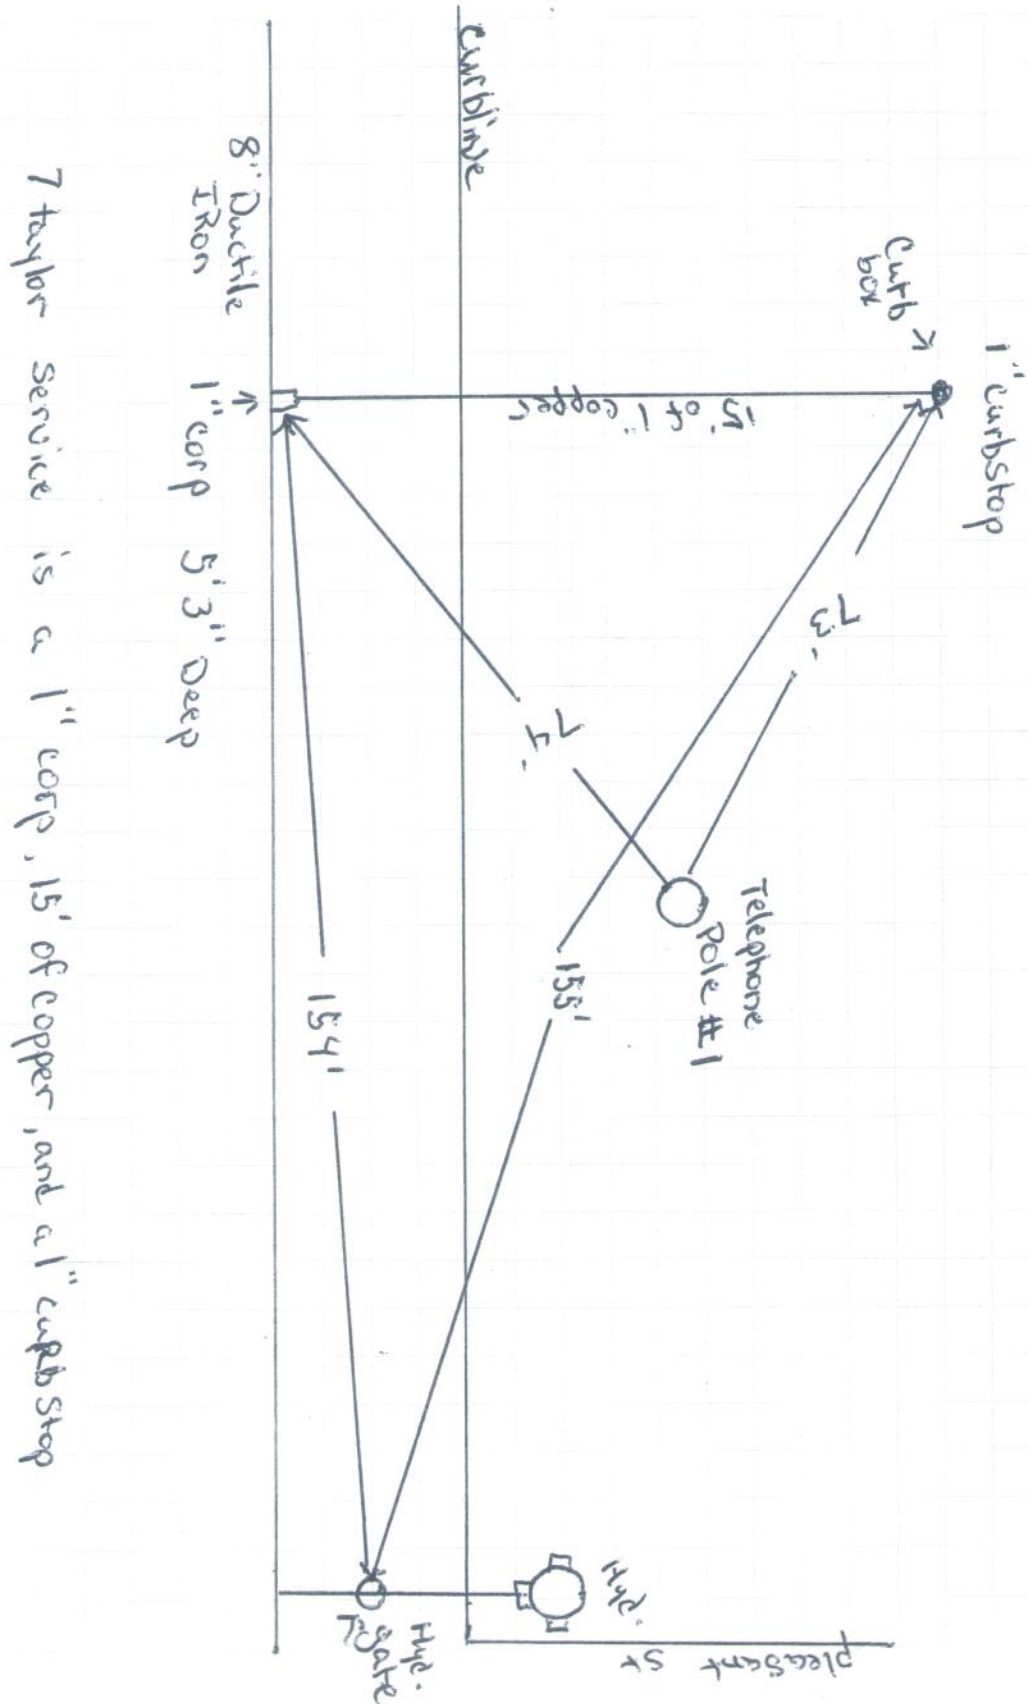

Taylor St