



EAST LONGMEADOW DEPARTMENT OF PUBLIC WORKS


Job: 7 Taylor St. (water)

Sheet No: _____ of _____

Calculated By: Pope Date 12-4-17

Scale: _____

Taylor St.

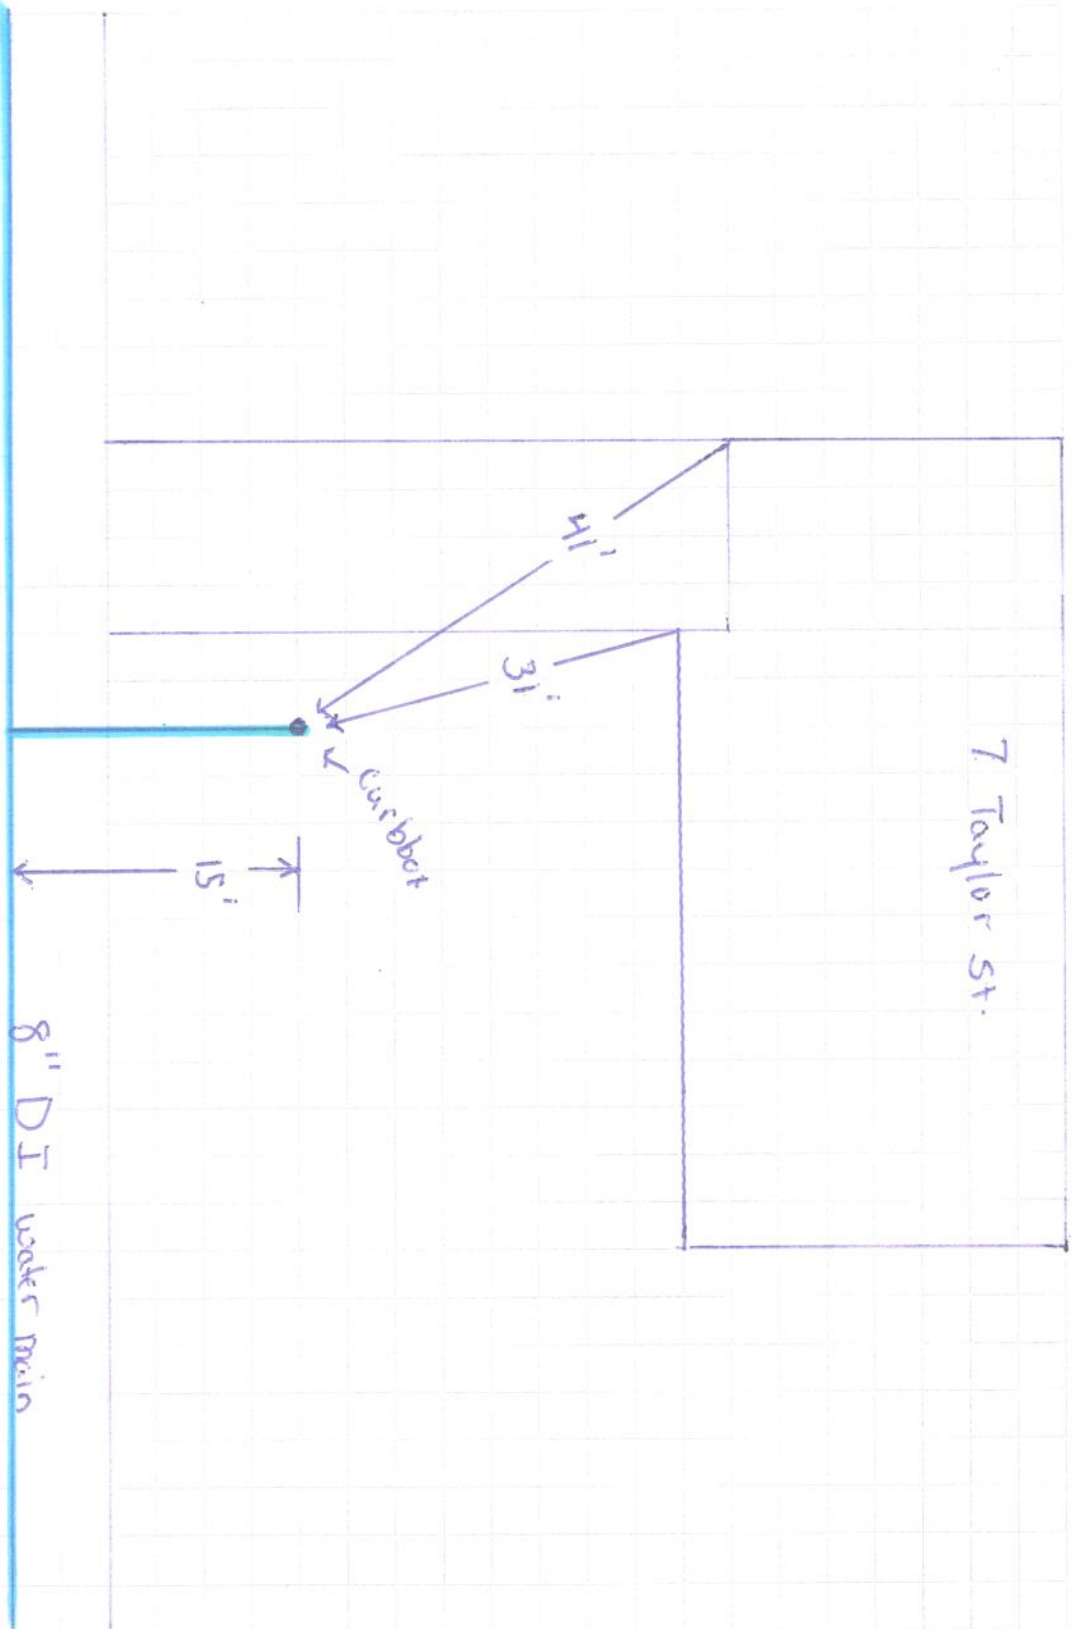

7 Taylor St.