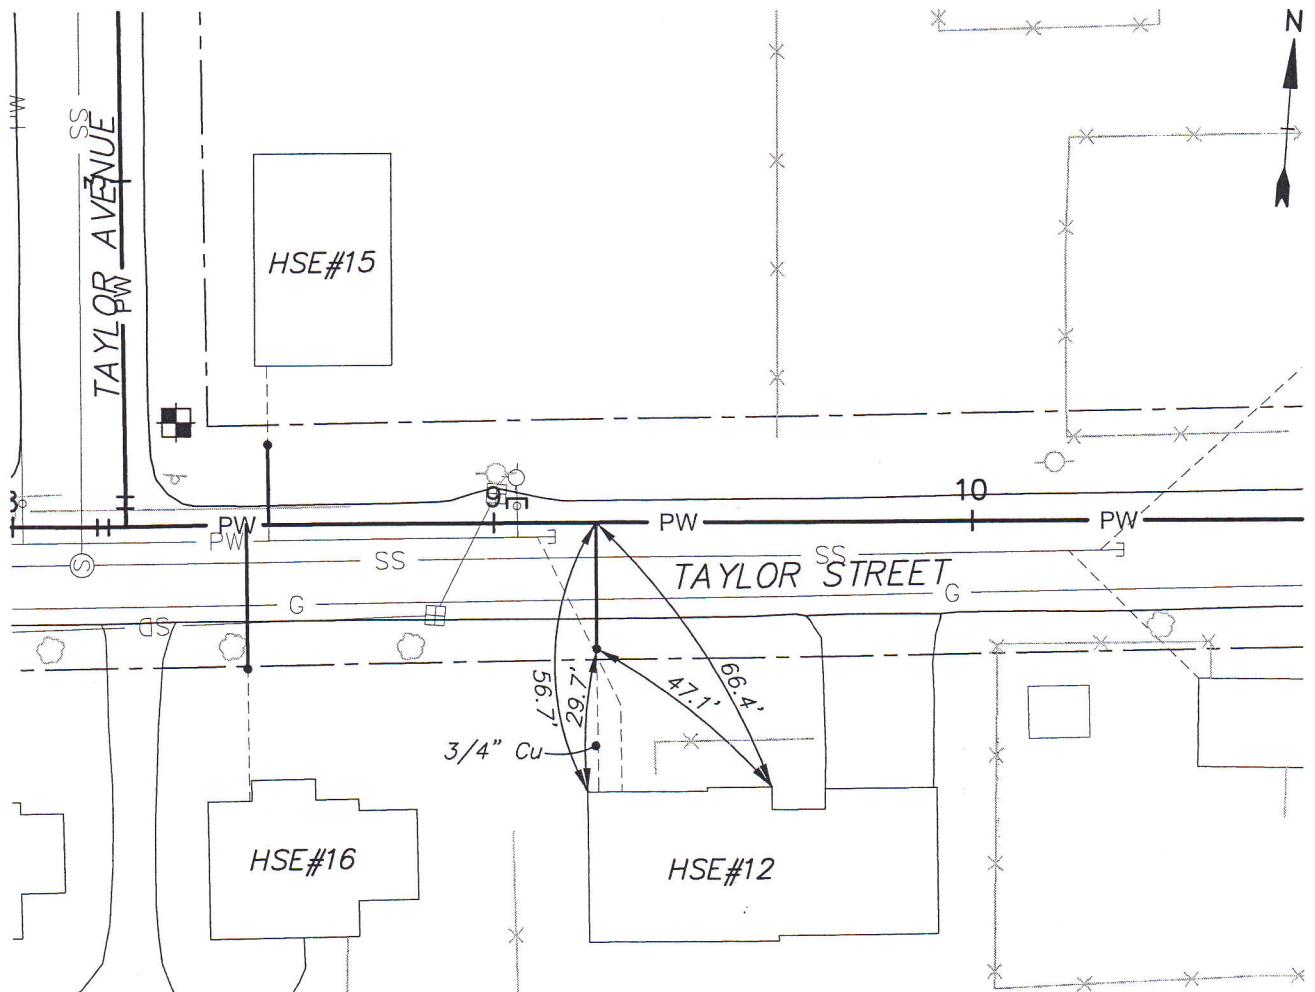


STREET ADDRESS: HSE#12 TAYLOR STREET

LOAM & SEED 14.8'x3.5'
 BIT. DRIVEWAY _____
 BIT. CURBS 4.8'
 BIT. SIDEWALK _____
 CONC. CURB _____
 CONC. SIDEWALK _____

Serv. Trench 24.0'x3.8'
7.8'x5.0'

SERVICE INSTALLED: 9-5-07
 SIZE: 1"
 MATERIAL: 1-CORP., 1-C. STOP WITH BOX
 DEPTH AT MAIN: 6.0'
 DEPTH AT CURB STOP: 5.0'
 LENGTH OF Cu PIPE: 28.0+6.0' = 34.0'

Berm at old hyd 13.0'
 L & S at old hyd 5'x4'