


JOB NO.: E526

STREET ADDRESS: HSE#15 TAYLOR STREET

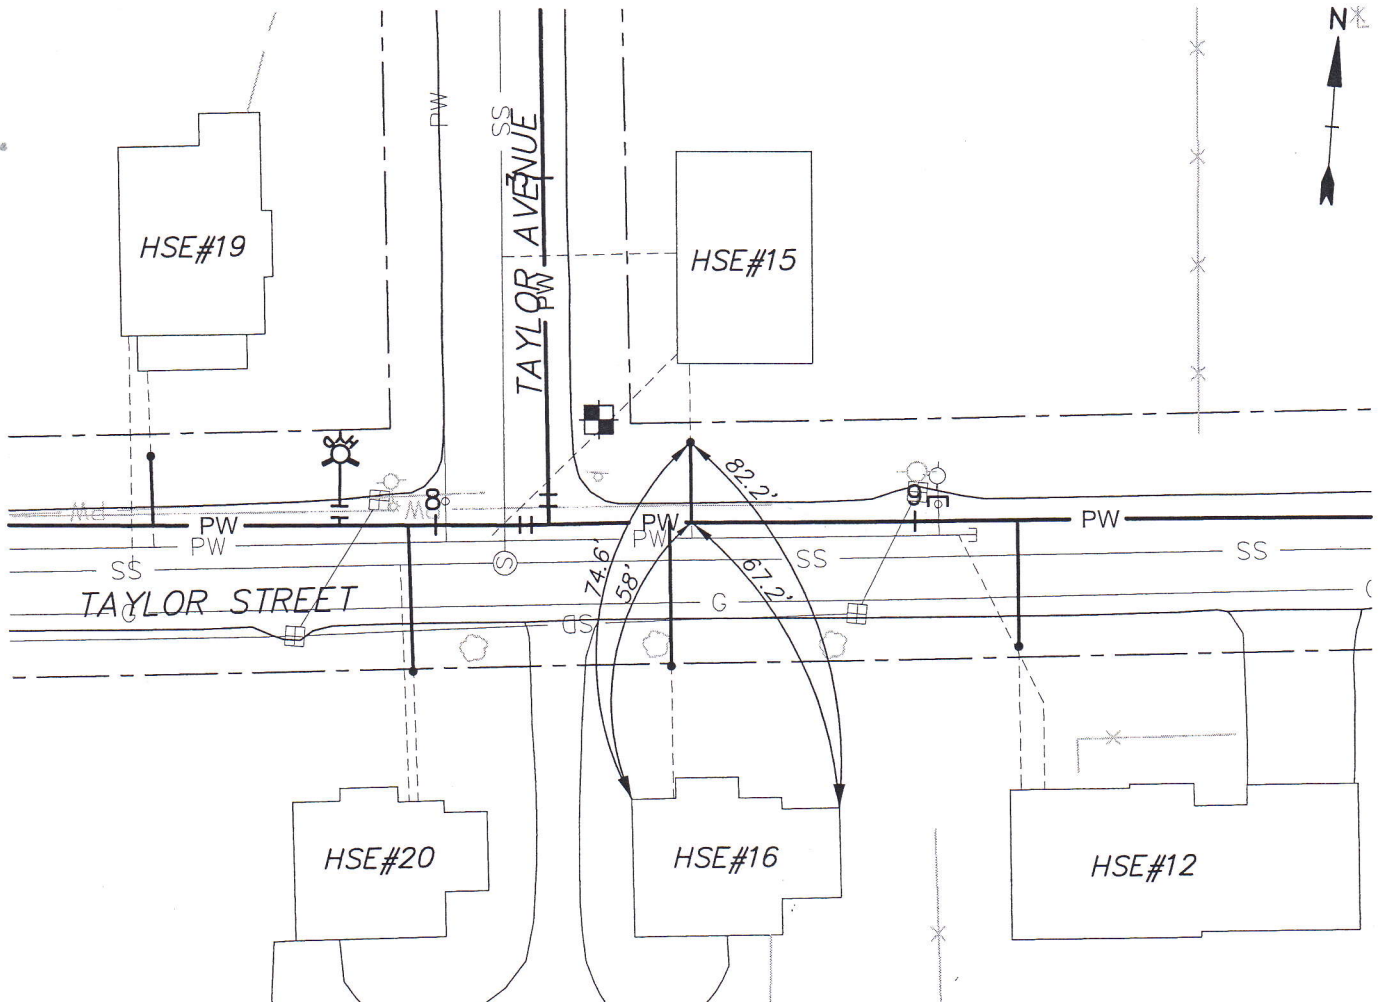

LOAM & SEED	<u>4.0'x12.0'</u>
BIT. DRIVEWAY	<u>                    </u>
BIT. CURBS	<u>4.0'</u>
BIT. SIDEWALK	<u>                    </u>
CONC. CURB	<u>                    </u>
CONC. SIDEWALK	<u>                    </u>

Trench Repair 4.0'x4.0'

SERVICE INSTALLED:	<u>9-5-07</u>
SIZE:	<u>1"</u>
MATERIAL:	<u>1-CORP., 1-C. STOP WITH BOX</u>
DEPTH AT MAIN:	<u>5.0'</u>
DEPTH AT CURB STOP:	<u>5.0'</u>
LENGTH OF Cu PIPE:	<u>17.5'+.5' = 18.0'</u>