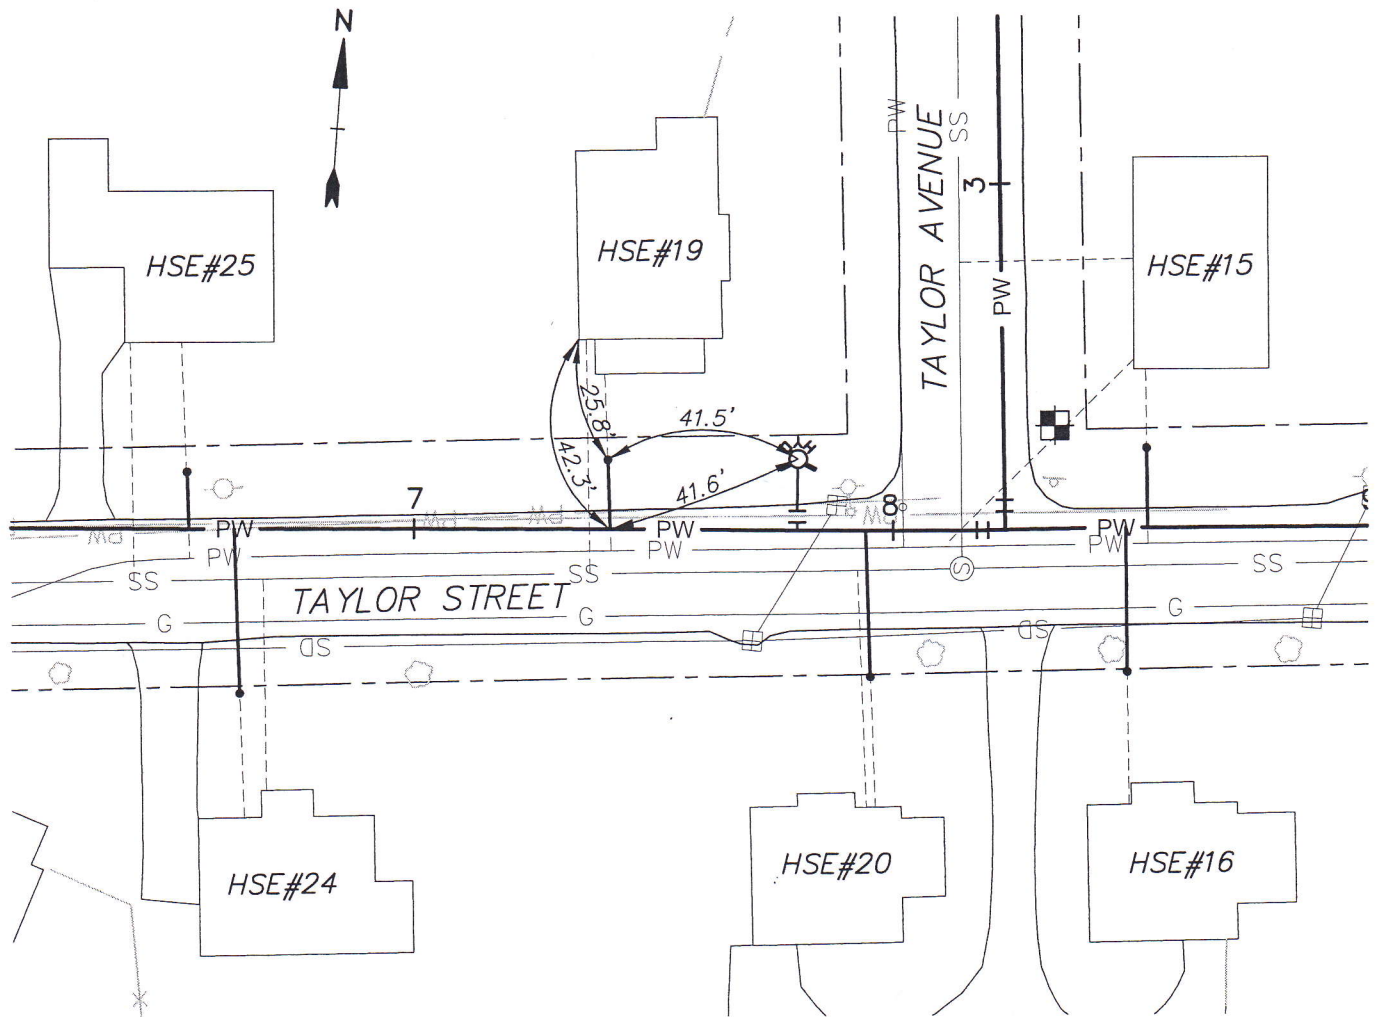


STREET ADDRESS: HSE#19 TAYLOR STREET

LOAM & SEED 11'x7.0'
 BIT. DRIVEWAY _____
 BIT. CURBS 6.7'
 BIT. SIDEWALK _____
 CONC. CURB _____
 CONC. SIDEWALK _____

Hyd L+Seed = 6'x6'
 Hyd Bit Curb = 11.5'
 Hyd Trench = 10.5'x6.0'

SERVICE INSTALLED: 9-4-07
 SIZE: 1"
 MATERIAL: 1-CORP., 1-C. STOP WITH BOX
 DEPTH AT MAIN: 5.5'
 DEPTH AT CURB STOP: 5.0'
 LENGTH OF Cu PIPE: 16.5'+.5' = 17.0'

Service trench 9.5'x4.0'