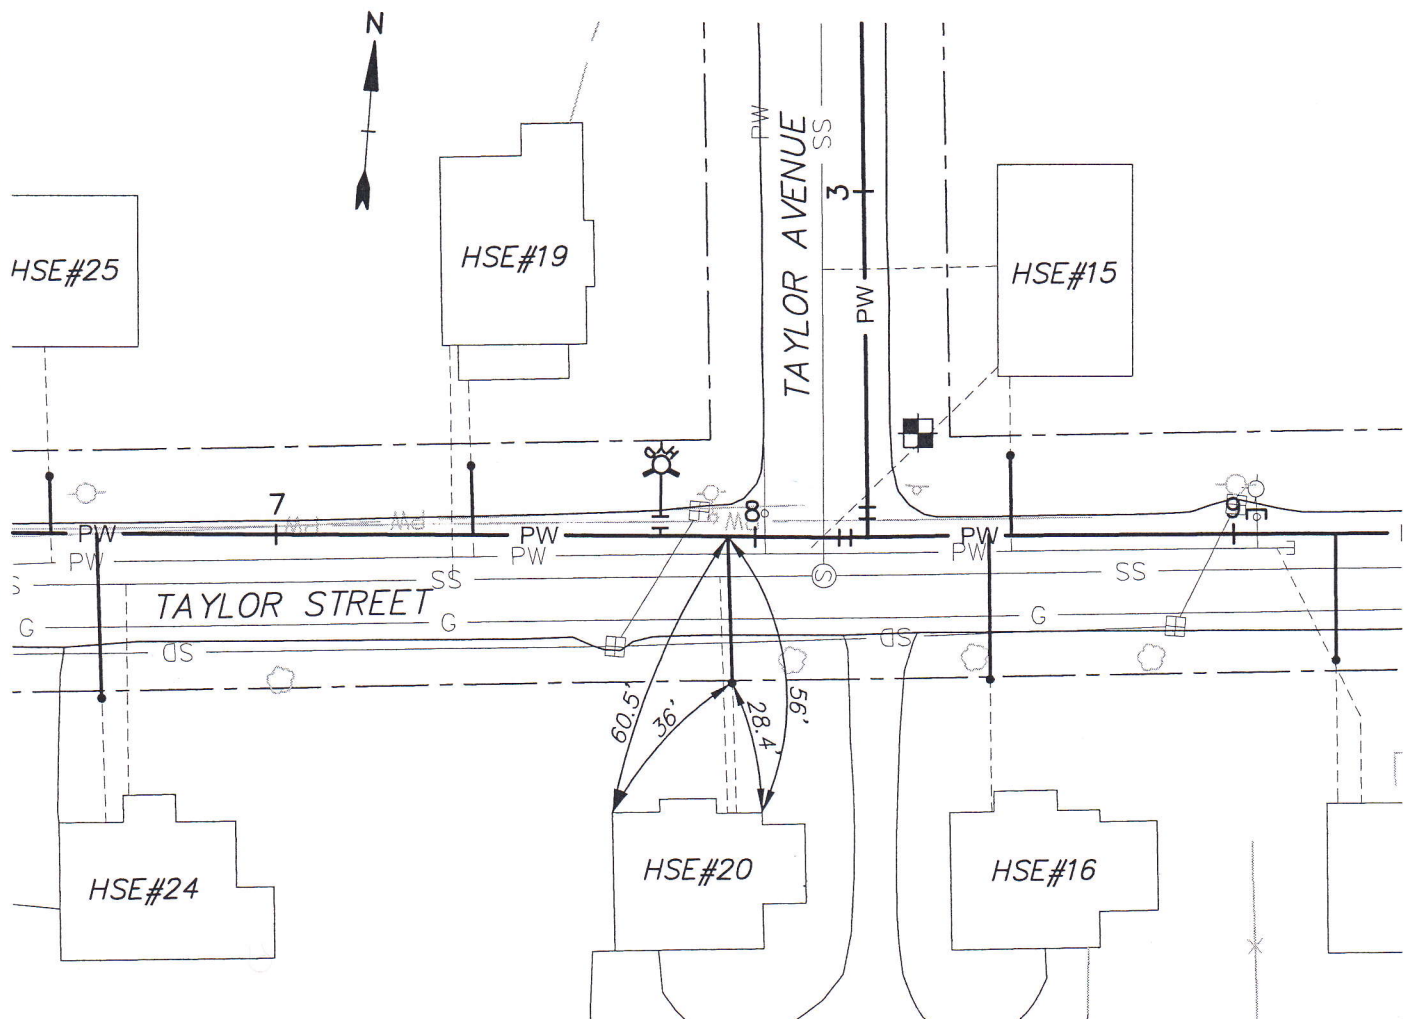


STREET ADDRESS: HSE#20 TAYLOR STREET

|                |          |
|----------------|----------|
| LOAM & SEED    | 10.5x4.0 |
| BIT. DRIVEWAY  |          |
| BIT. CURBS     | 4.0'     |
| BIT. SIDEWALK  |          |
| CONC. CURB     |          |
| CONC. SIDEWALK |          |

Trench repair 22.0'x3.5'

|                     |                             |
|---------------------|-----------------------------|
| SERVICE INSTALLED:  | 9-6-07                      |
| SIZE:               | 1"                          |
| MATERIAL:           | 1-CORP., 1-C. STOP WITH BOX |
| DEPTH AT MAIN:      | 5.3'                        |
| DEPTH AT CURB STOP: | 4.6'                        |
| LENGTH OF Cu PIPE:  | 28.7+.8' = 29.5'            |