


STREET ADDRESS: HSE#24 TAYLOR STREET

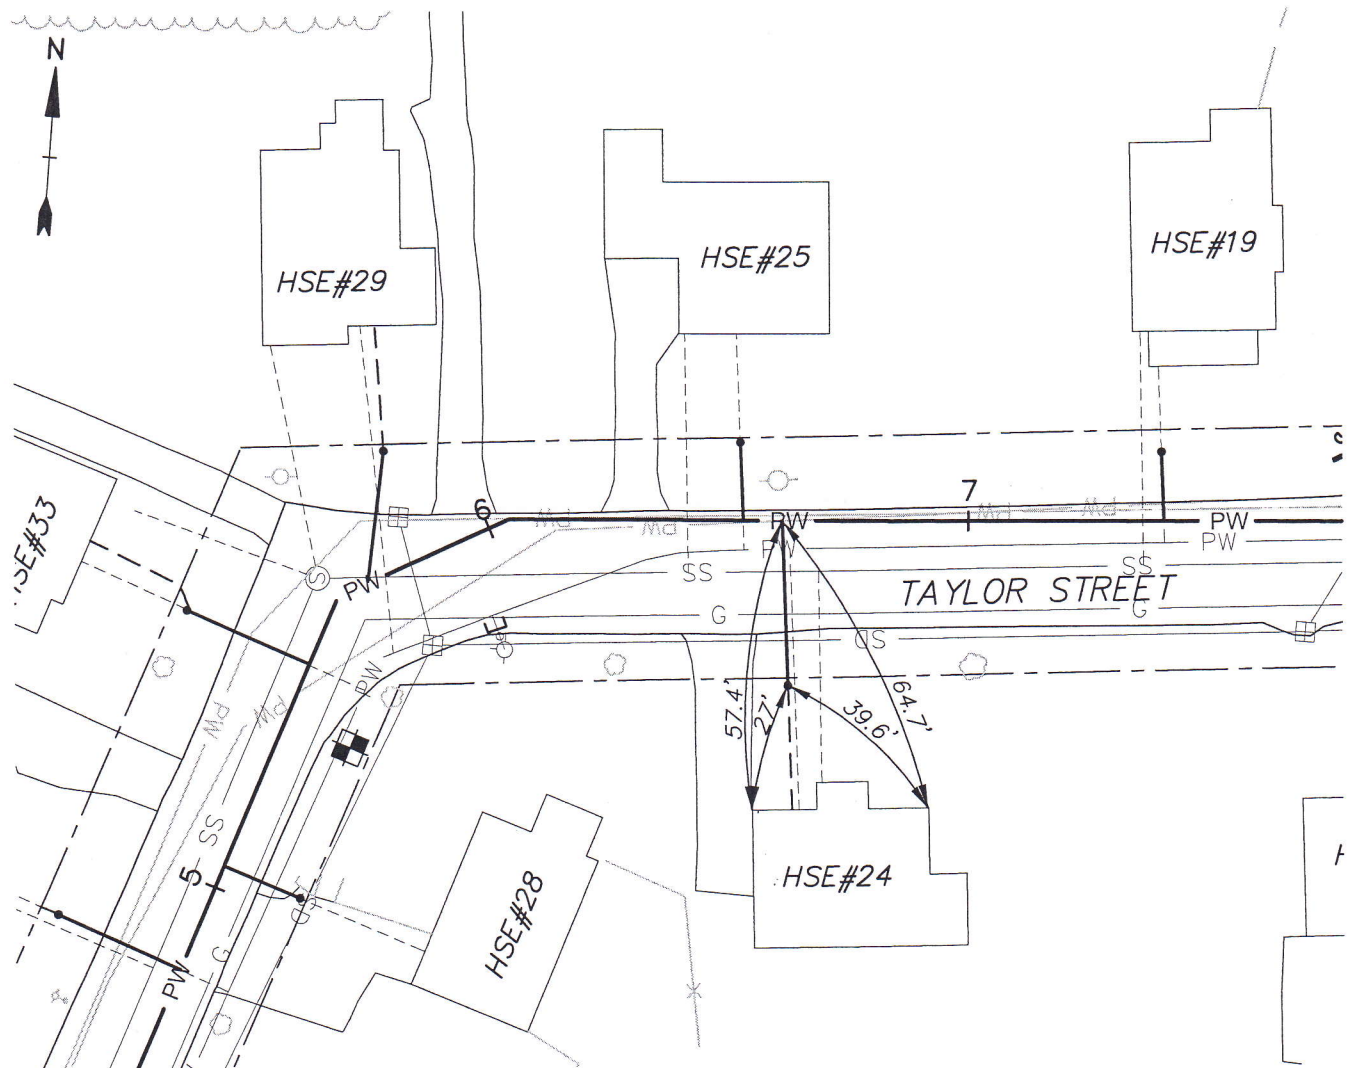

LOAM & SEED	13.0'x3.5'
BIT. DRIVEWAY	
BIT. CURBS	7.0'
BIT. SIDEWALK	
CONC. CURB	
CONC. SIDEWALK	

Serv. Trench 24.5'x4.0'

SERVICE INSTALLED: 9-6-07

SIZE: 1"

MATERIAL: 1-CORP., 1-C. STOP WITH BOX

DEPTH AT MAIN: 4.5'

DEPTH AT CURB STOP: 5.0'

LENGTH OF Cu PIPE: 31.0' + 3.0' = 34.0'