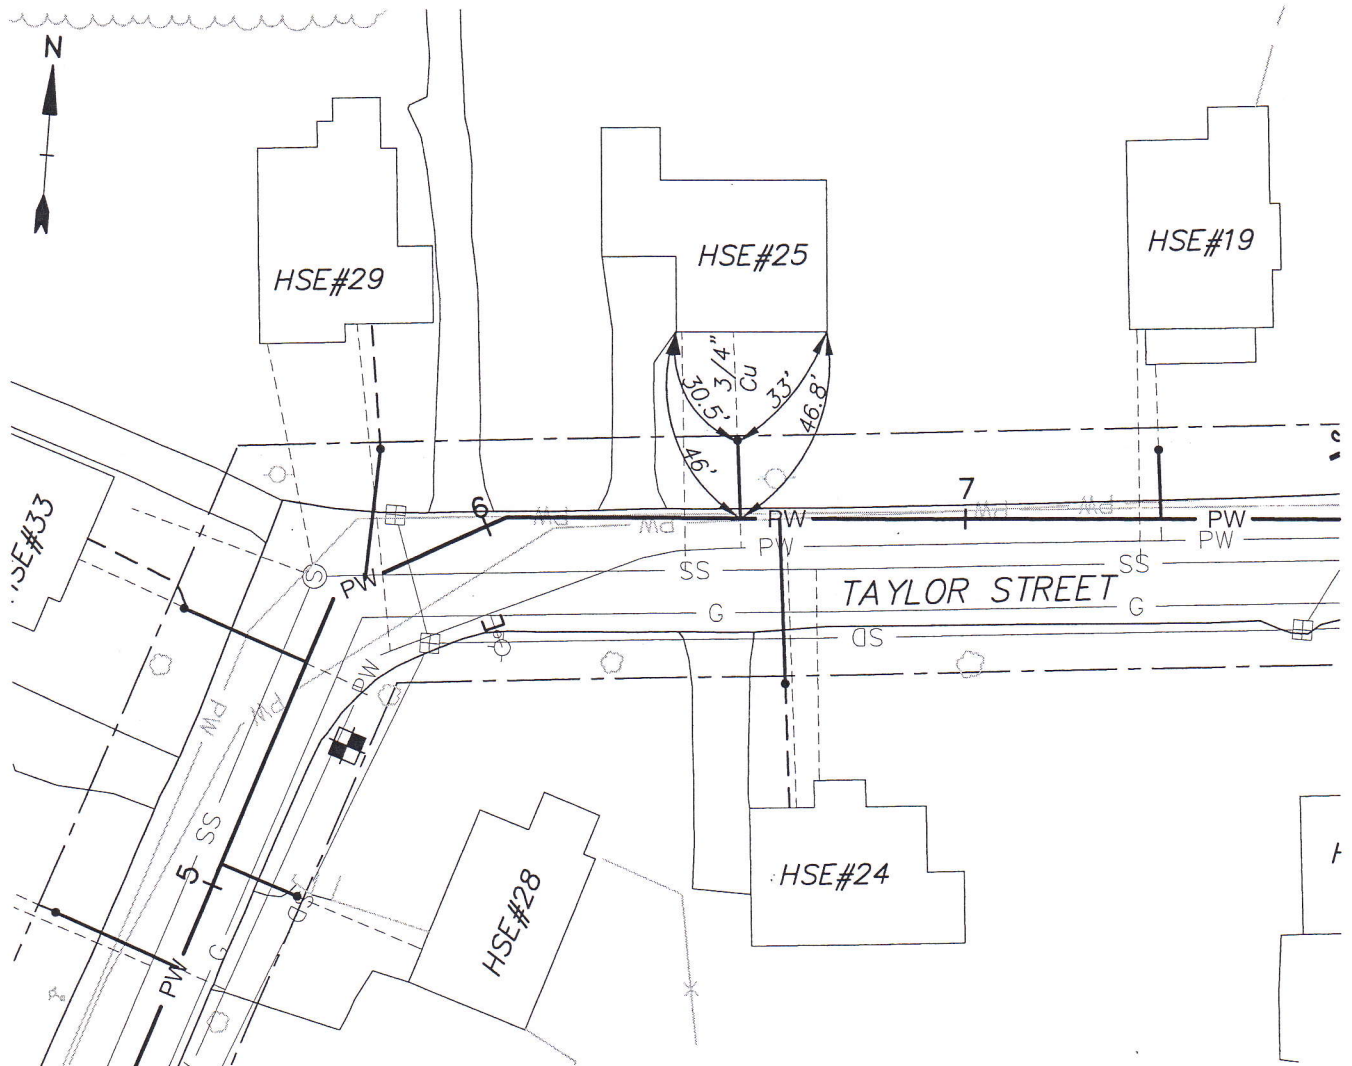


STREET ADDRESS: HSE#25 TAYLOR STREET

LOAM & SEED 11.5x5.0

BIT. DRIVEWAY _____

BIT. CURBS 8.0'

BIT. SIDEWALK _____

CONC. CURB _____

CONC. SIDEWALK _____

Serv. Trench 9.0'x3.8'

SERVICE INSTALLED: 9-4-07

SIZE: 1"

MATERIAL: 1-CORP., 1-C. STOP WITH BOX

DEPTH AT MAIN: 4.7'

DEPTH AT CURB STOP: 5.0'

LENGTH OF Cu PIPE: 16.5'+.5' = 17.0'