


STREET ADDRESS: HSE#29 TAYLOR STREET

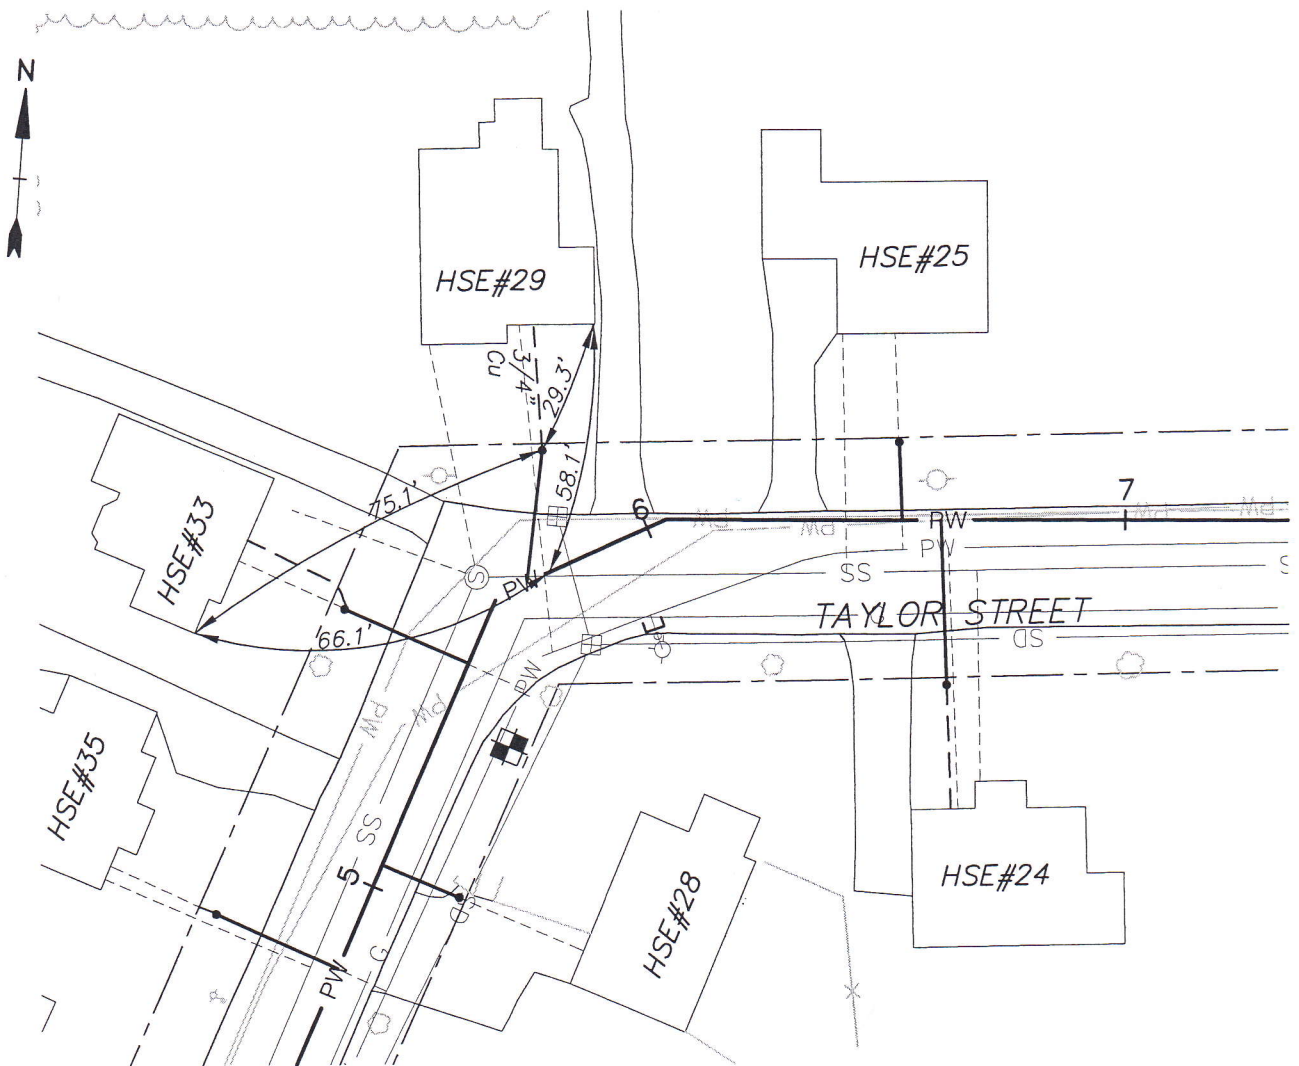

LOAM & SEED	<u>13.5'x4'</u>
BIT. DRIVEWAY	<u> </u>
BIT. CURBS	<u>7.5'</u>
BIT. SIDEWALK	<u> </u>
CONC. CURB	<u> </u>
CONC. SIDEWALK	<u> </u>

Trench Repair 20.7'x4.0'

SERVICE INSTALLED: 9-6-07

SIZE: 1"

MATERIAL: 1-CORP., 1-C. STOP WITH BOX

DEPTH AT MAIN: 5.2'

DEPTH AT CURB STOP: 5.0'

LENGTH OF Cu PIPE: 29.0'+1.0' = 30.0'