


STREET ADDRESS: HSE#33 TAYLOR STREET

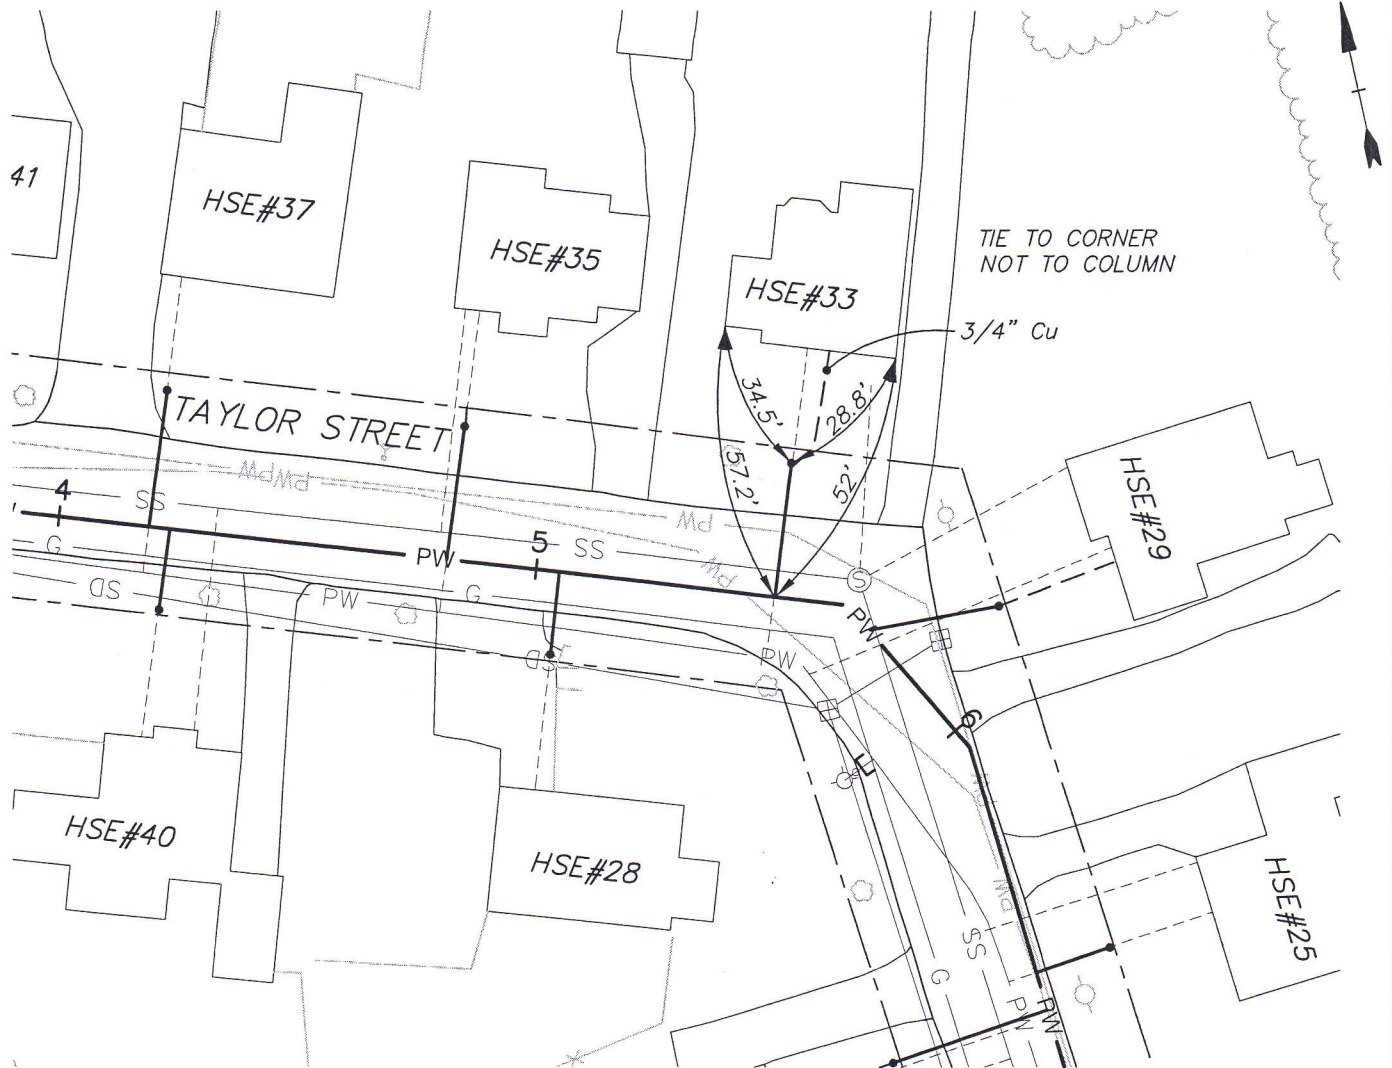

LOAM & SEED 11'x4.5'
 BIT. DRIVEWAY _____
 BIT. CURBS 3.7'
 BIT. SIDEWALK _____
 CONC. CURB _____
 CONC. SIDEWALK _____

SERVICE INSTALLED: 9-4-07
 SIZE: 1"
 MATERIAL: 1-CORP., 1-C. STOP WITH BOX
 DEPTH AT MAIN: 5.5'
 DEPTH AT CURB STOP: 5.0'
 LENGTH OF Cu PIPE: 25.5'+3.0' = 28.5'