


STREET ADDRESS: HSE#37 TAYLOR STREET

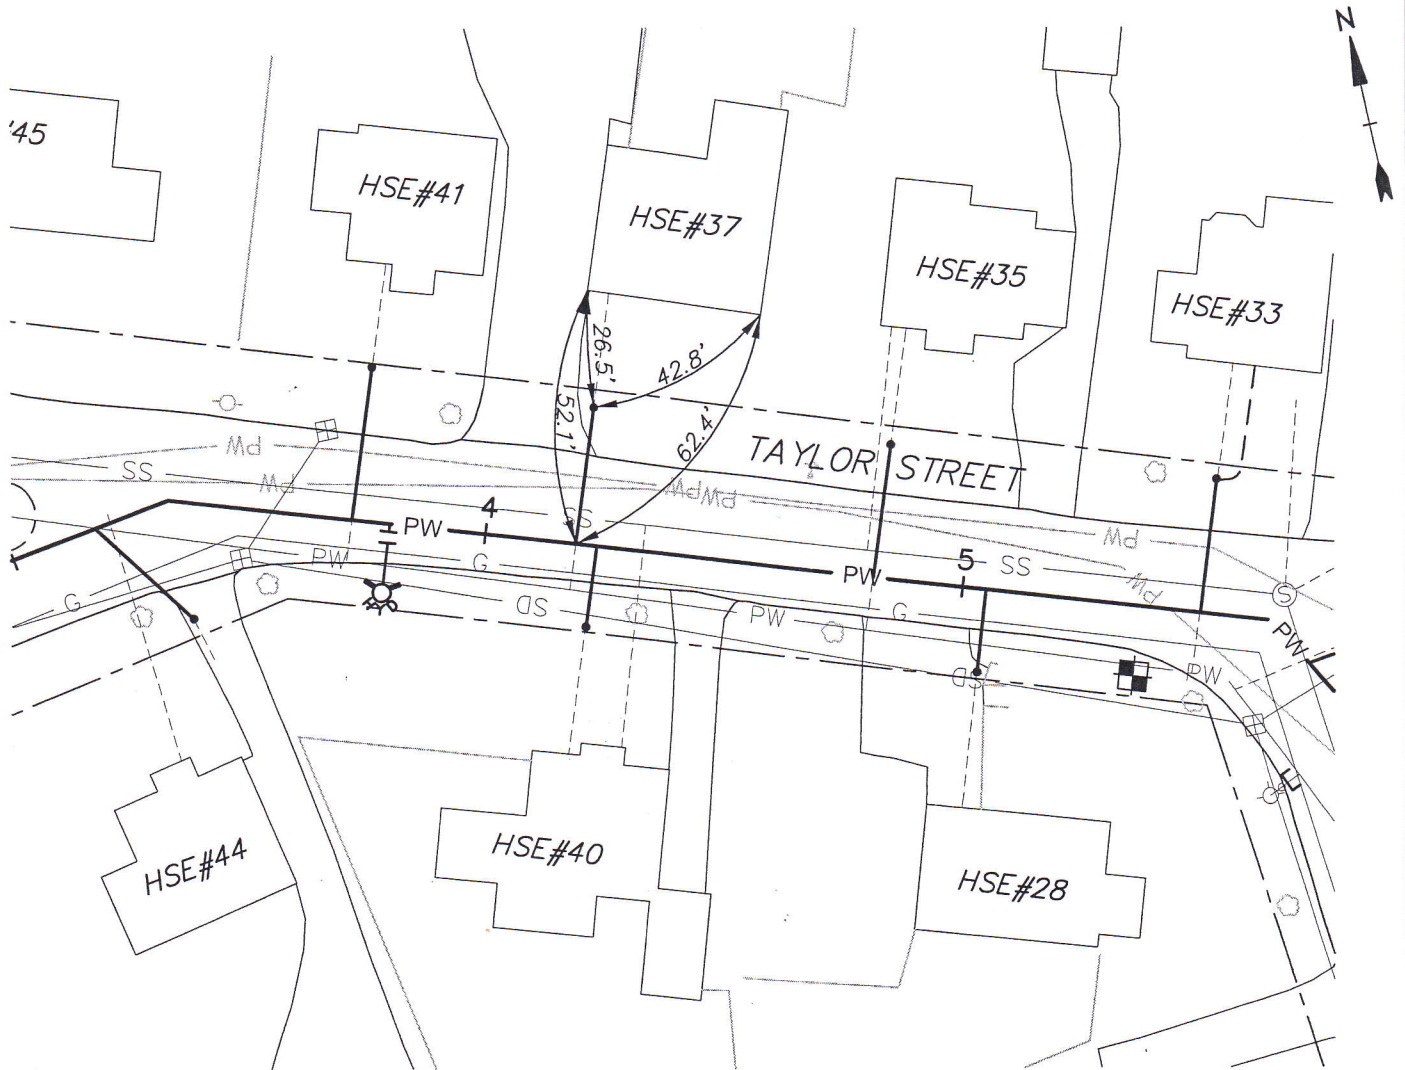

LOAM & SEED \_\_\_\_\_  
 BIT. DRIVEWAY \_\_\_\_\_  
 BIT. CURBS \_\_\_\_\_  
 BIT. SIDEWALK \_\_\_\_\_  
 CONC. CURB \_\_\_\_\_  
 CONC. SIDEWALK \_\_\_\_\_

SERVICE INSTALLED: 8-30-07  
 SIZE: 1"  
 MATERIAL: 1-CORP., 1-C. STOP WITH BOX  
 DEPTH AT MAIN: 5.0'  
 DEPTH AT CURB STOP: 5.0'  
 LENGTH OF Cu PIPE: 26.5'+1.0' = 27.5'