


JOB NO.: E526

STREET ADDRESS: HSE#48 TAYLOR STREET

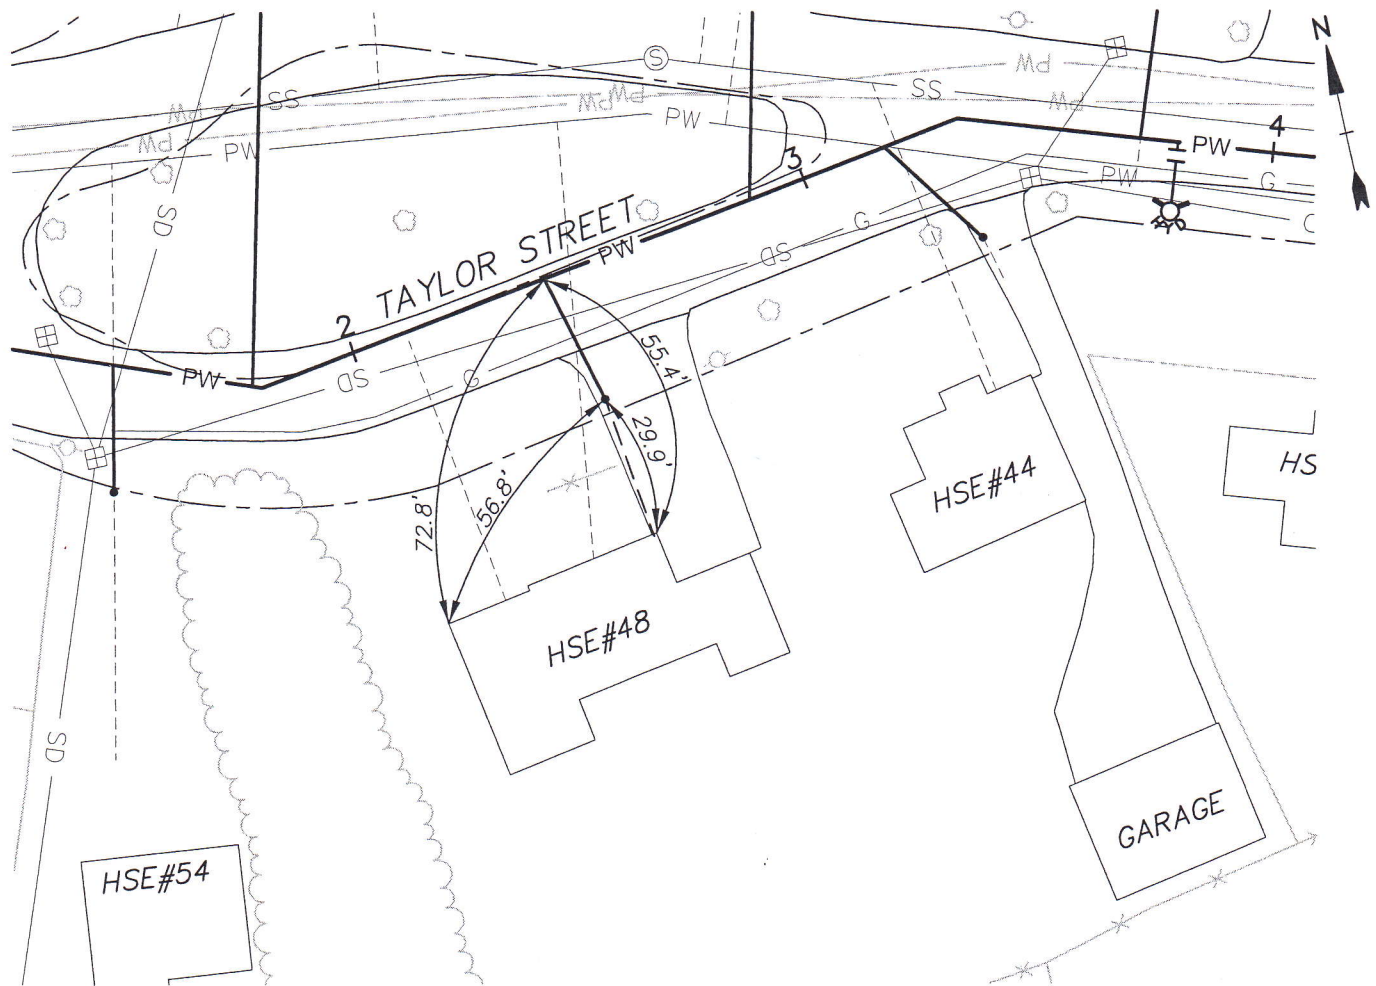

LOAM & SEED _____
BIT. DRIVEWAY _____
BIT. CURBS _____
BIT. SIDEWALK _____
CONC. CURB _____
CONC. SIDEWALK _____

SERVICE INSTALLED: 9-4-07
SIZE: 1"
MATERIAL: 1-CORP., 1-C. STOP WITH BOX
DEPTH AT MAIN: 5.0'
DEPTH AT CURB STOP: 5.0'
LENGTH OF Cu PIPE: 26.0' + .7' = 26.7'

Broke 8" vc drain (2.5' cover)
R & R 3.6' 8" pvc + 2-ferncos