


# VERANDA AVENUE - #22

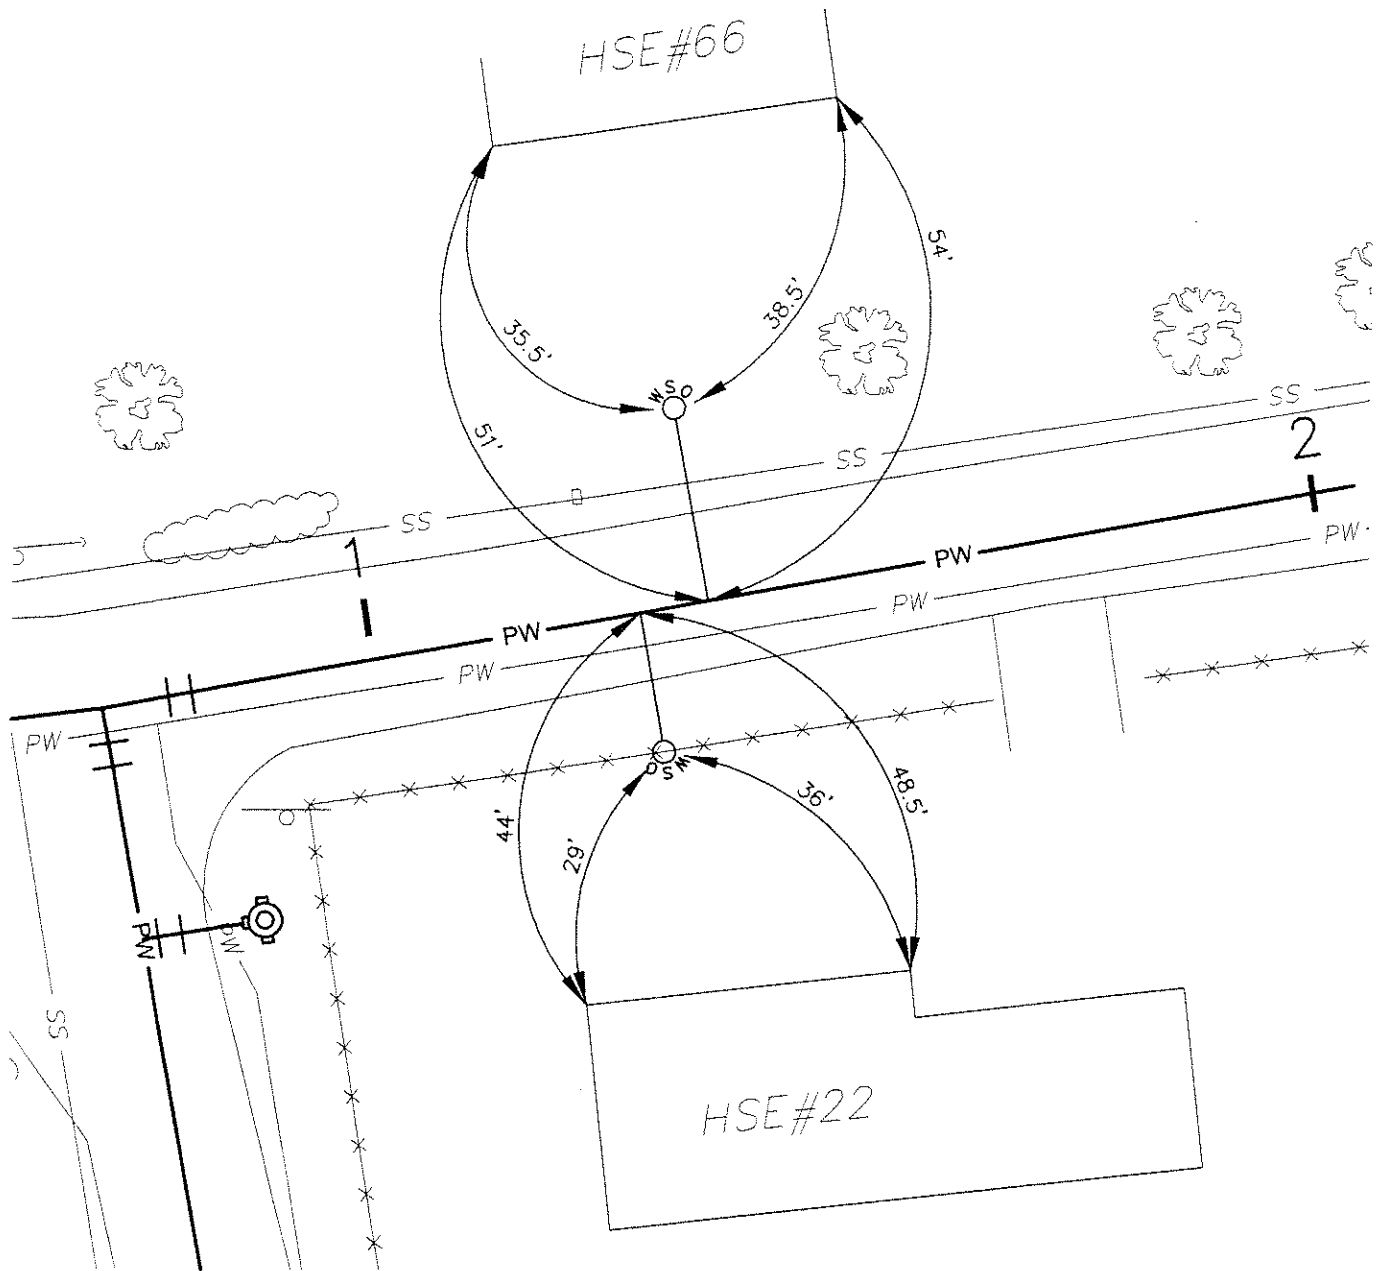

## HOUSE SERVICE INFORMATION:

DEPTH AT MAIN: 5'  
DEPTH AT PROPERTY LINE: 5'  
DATE INSTALLED: 10/14/04

PREPARED BY TIGHE & BOND