

NO. STREET


DATE INST.

MAKE:

SIZE

30 VREELAND AVE

5-21-13

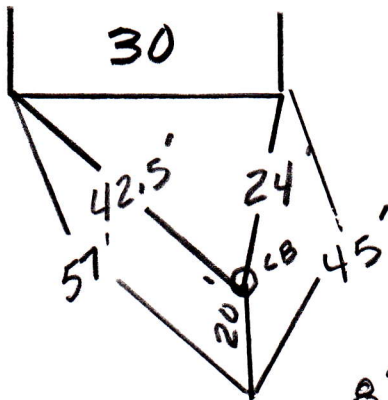

1" COPPER

8" DI - 5' DEEP