


16 Westwood Avenue

1994

#16

1" CTSP M-C

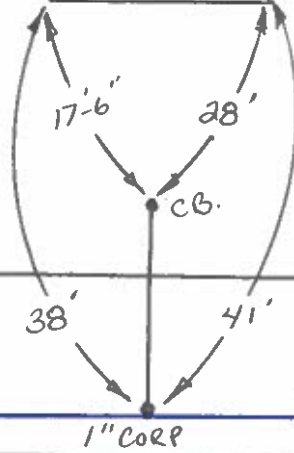

12" DI MAIN