


24 Westwood Avenue

1994

#24

1" CTSP M-C

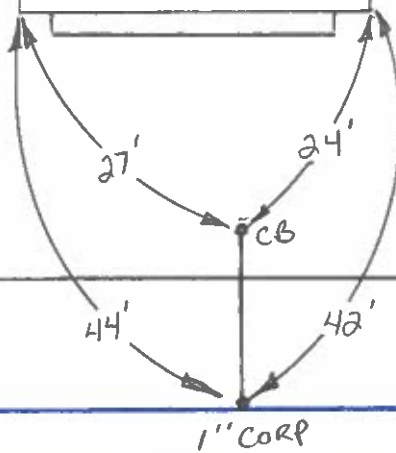

12" DI MAIN