


105 Westwood AVENUE

1994

#105

1" CtSP m-c

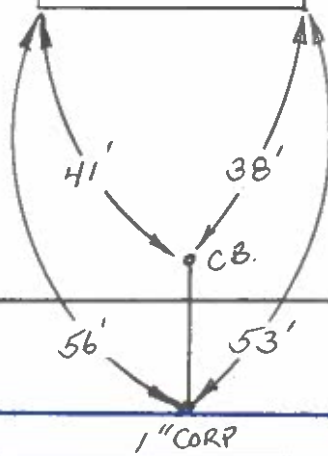

12" DI MAIN

1" CORP