


203 Westwood Avenue 1994

#203

1"ctsp m-c

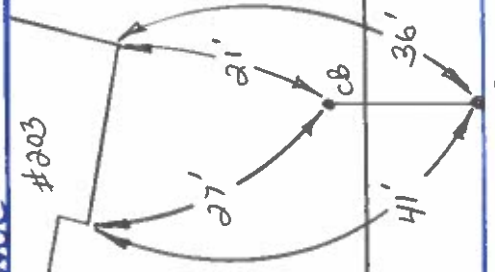

12" DI MAIN