


221 Westwood AVENUE

1994

1" cts p m-c.

#221

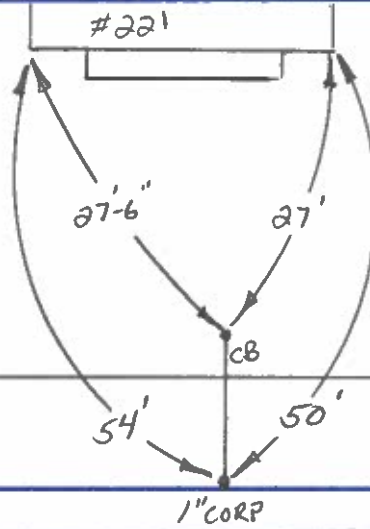

James Street

12" DI MAIN

1" CORP