

NO. STREET


DATE INST.

MAKE:

SIZE

41 WINDSOR LAWE

6-19-13

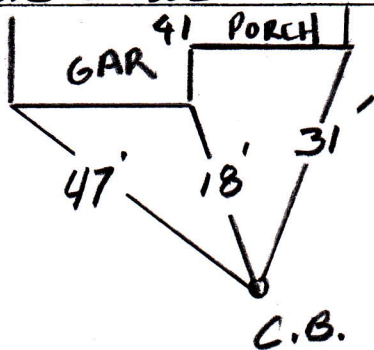

1" COPPER