

NO. STREET


DATE INST.

MAKE:

SIZE

6 AMARETTA AVE

1"

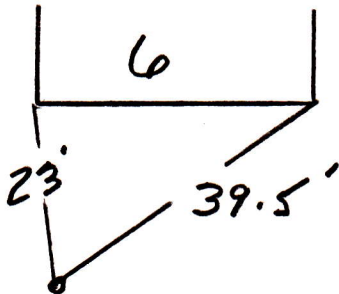

RODERICK AVE.