

NO. STREET


DATE INST.

MAKE:

SIZE

8 AUBURN ST.

6-28-13

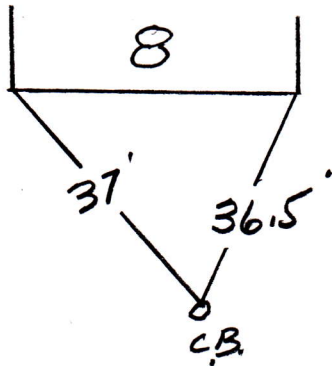

1" COPPER