

NO. STREET


DATE INST.

MAKE:

SIZE

11 BETTERLEY LANE

5-11-12

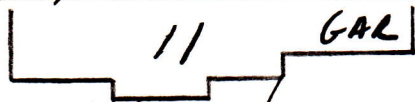

1" COPPER
19' BETWEEN CB
& SANITARY

78'

HYD

Q

5
2