

NO. STREET


DATE INST.

MAKE:

SIZE

3 BIRCH AVE

1-22-07

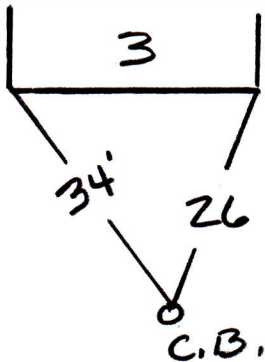

1" COPPER