

NO. STREET

DATE INST.


MAKE:

SIZE

82 BIRCH AVE

6-1-07

BIRCH

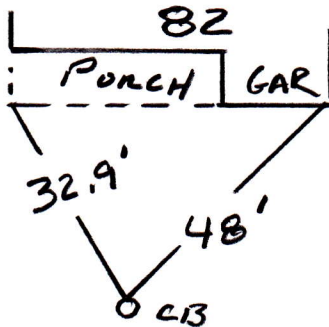

1" COPPER

VINELAND