

NO. STREET


DATE INST.

MAKE:

SIZE

5 BLACK DOG LANE

6-20-12

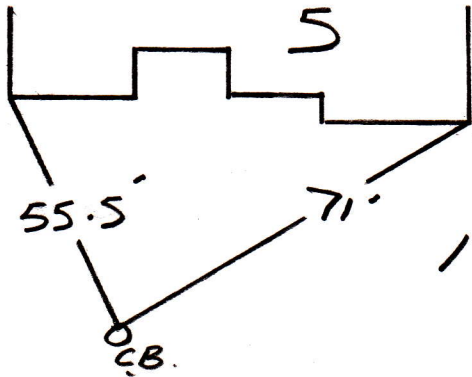

1" COPPER