

NO. STREET


DATE INST.

MAKE:

SIZE

131 CANTERBURY CIR.

5-21-08

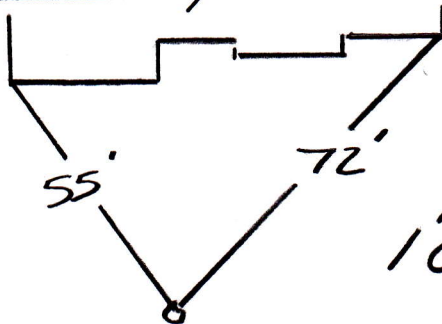

1" COPPER