


NO. STREET

DATE INST.

MAKE:

SIZE

147 CANTERBURY LAN

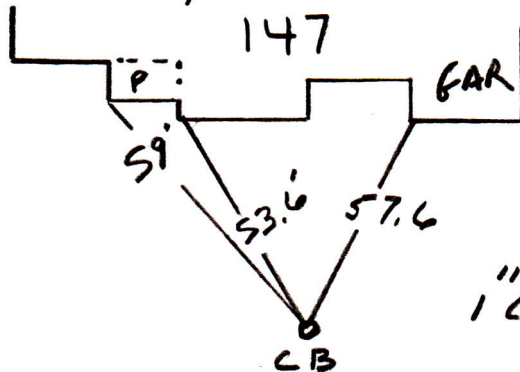

1" COPPER