

NO. STREET


DATE INST.

MAKE:

SIZE

203 CANTERBURY CIR.

6-11-07

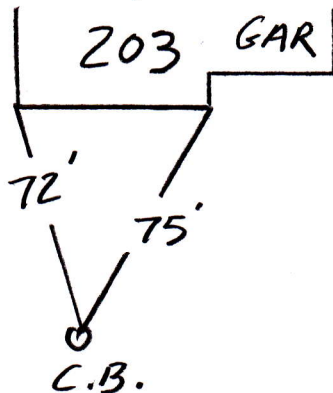

1" COPPER