

NO. STREET


DATE INST.

MAKE:

SIZE

211 CANTERBURY CIR

1-5-07

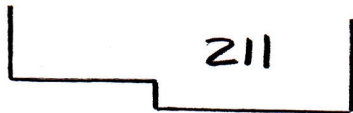

1" COPPER

